


*Reno*

Form 51-5M-5-34-Palace

Map No. KANCA Sec. 24 Twp. 23 R. 4W

Well No. F. Johnson Farm  
Allen & Shell Company

NORTH

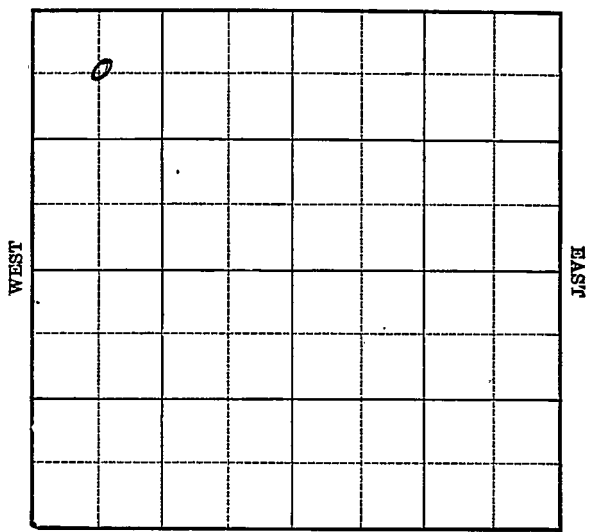

SOUTH

Location \_\_\_\_\_

Drilling Remarks \_\_\_\_\_

\_\_\_\_\_

\_\_\_\_\_

Rig Up \_\_\_\_\_

Drilling Remarks \_\_\_\_\_

\_\_\_\_\_

\_\_\_\_\_

**RECORD**

Cased \_\_\_\_\_ in. \_\_\_\_\_ ft.

Sand \_\_\_\_\_

Gas \_\_\_\_\_

Oil \_\_\_\_\_

Total Depth \_\_\_\_\_

**PRODUCTION**

1st 24 hrs. Nat. \_\_\_\_\_

1st 24 hrs. after shot \_\_\_\_\_

Gas \_\_\_\_\_ cu. ft.

Dry Hole \_\_\_\_\_


Abandoned \_\_\_\_\_

Revo

Map No. KANSA<sup>s</sup> Sec. 24 Twp. 23 R. 400

Well No. # 2 Johnson Farm  
Olsen & Shell Company

660 Ft. from N. Line  
  
Ft. from S. Line  
  
Ft. from E. Line  
  
660 Ft. from W. Line

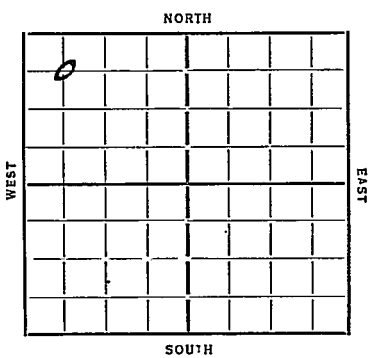

| Date | REPORT                         |
|------|--------------------------------|
| 1935 |                                |
| 1/9  | Location                       |
| 1/17 | Rig                            |
| 1/24 | <del>1/31</del> — 2/7 — 2/14 — |
| 2/21 | Material                       |
| 2/28 | Rig                            |
| 3/7  | 18 1/2 150                     |
| 3/14 | Qty 1772                       |
| 3/21 | " 2786                         |
| 3/28 | " 3260 Chat 3257               |
| 4/4  | " 3319                         |
| 4/11 | " 3368 5 1/2 M Gas 50          |
|      | Tubing                         |
| 4/18 | — 4/26 —                       |
| 5/2  | 14 oil 17 hrs 10 M Gas.        |
| 5/8  | Chat 3257 + 7 3368             |
|      | 10 Bbls oil                    |
|      | 10 M Gas.                      |
|      | <b>COMPLETED</b>               |

Map No. 40 Sec. 24 Twp. 23 R. 4W

Well No. 2-Johnson

Olsen + Shell Company

Contractor

FIRST REPORTS

660 Ft. from N. Line

..... Ft. from S. Line

..... Ft. from E. Line

660 Ft. from W. Line

SECTION PLAT

|   |  |  |  |
|---|--|--|--|
| 0 |  |  |  |
|   |  |  |  |
|   |  |  |  |
|   |  |  |  |

Location ✓

Rig up

Drilling and Remarks:

RECORD

Cased..... in., ..... ft.

Sand.....

Gas.....

Oil.....

Total Depth.....

PRODUCTION

1st 24 hrs. Nat.....

1st 24 hrs. after shot.....

Gas..... Cu. Ft.

Dry Hole.....

Abandoned.....

ORVAL MANSCHRECK

Date

1-9-35 192

Scout

Map No. 40 Sec. 24 Twp. 23 R. 4W

Well No. 2-Johnson

Olsen + Shell Company

Contractor

**COMPLETED**

SECTION PLAT

660 Ft. from N. Line

..... Ft. from S. Line

..... Ft. from E. Line

660 Ft. from W. Line

|   |  |  |  |
|---|--|--|--|
| 0 |  |  |  |
|   |  |  |  |
|   |  |  |  |
|   |  |  |  |
|   |  |  |  |

Location.....

Rig up.....

Drilling and Remarks:

10 ffb oil  
10 m. gas

RECORD

Cased..... in..... ft.  
Sand Chat 3257  
Gas.....  
Oil.....  
Total Depth 3368

PRODUCTION

1st 24 hrs. Nat.....  
1st 24 hrs. after shot.....  
Gas..... Cu. Ft.  
Dry Hole.....  
Abandoned.....

**ORVAL MANSCHRECK**

Date

5-8-35 192.....

Scout