


Map No. KANSAS Sec. 24 Twp. 23 R. 4W

Well No. 4- Rudical Farm
Olson Oil Company

660 Ft. from N. Line
Ft. from S. Line
660 Ft. from E. Line
Ft. from W. Line

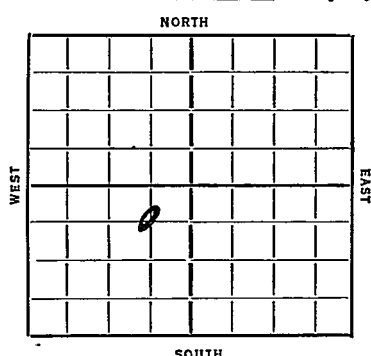

REPORT

~~1/26~~
 2/12 Rig
 2/21 Log
 2/28 16" 250 WOC
 3/6 Dlg 1680
 3/13 Drlg. 2920
 3/20 7" - 3276 T.D. 3000 Bailing.
 3/27 T.Chat 3262' T.D. 3372' 1000 acid.
 4/2 --
 4/1 Chat 3262
 TD 3372
 1000 acid
 293 Bbls.

COMPLETED

Map No. 40 Sec. 24 Twp. 23 R. 4W

Well No. #4 - Rudical

Olson oil Company

Contractor

REPORTS

SECTION PLAT

660 Ft. from N. Line

..... Ft. from S. Line

660 Ft. from E. Line

..... Ft. from W. Line

	0		

Location.....

Rig up.....

Drilling and Remarks:

Rig

RECORD

Cased..... in., ft.

Sand.....

Gas.....

Oil.....

Total Depth.....

PRODUCTION

1st 24 hrs. Nat.....

1st 24 hrs. after shot.....

Gas..... Cu. Ft.

Dry Hole.....

Abandoned.....

Date

2-12-36 192

OBVA' MANNSCHECK Scout

Map No. 40 Sec. 24 Twp. 23 R. 4^W

Well No. 4 - Rudical

Olson oil - Company

Contractor

COMPLETE

SECTION PLAT

660 Ft. from N. Line

..... Ft. from S. Line

660 Ft. from E. Line

..... Ft. from W. Line

	0		

Location.....

Rig up.....

Drilling and Remarks:

1000 acid

293 bbls

RECORD

Cased..... in, ft.

Sand Chat 3262

Gas.....

Oil.....

Total Depth 3372

PRODUCTION

1st 24 hrs. Nat.....

1st 24 hrs. after shot.....

Gas..... Cu. Ft.

Dry Hole.....

Abandoned.....

Date

ORVAL MANSCHRECK

4-1-36 192.....

Scout