


Keno

Map No. KANSAS Sec. 24 Twp. 23 R. 4^W

Well No. Hutchinson Lumber Co. Farm
Olsen & Shell Company

660' Ft. from N. Line
_____ Ft. from S. Line
660' Ft. from E. Line
_____ Ft. from W. Line

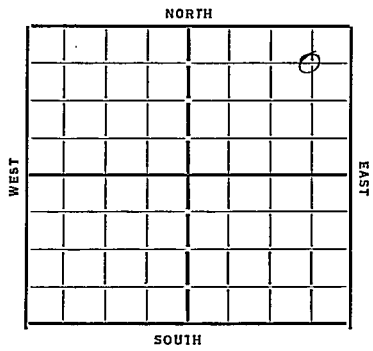

Date 7/22

REPORT

<u>4/26</u>	<u>R.O.G</u>
<u>5/4</u>	<u>Regn up</u>
<u>5/10</u>	<u>15" 266 Wily 265'</u>
<u>5/17</u>	<u>Wily 2530'</u>
<u>5/24</u>	<u>log 2749</u>
<u>6/1</u>	<u>Chat 3265 8" 3275 Run</u>
<u>6/14</u>	<u>Chat 3265- T.D. 3377</u>
	<u>170 bbls</u>
	COMPLETED

Reno

W

40 KANSAS Sec. 24 Twp. 23 R. 4

Well No. 1 Hutchinson Lumber Co

Olsen & Shee Company

Contractor

FIRST REPORTS

660 Ft. from N. Line

Ft. from S. Line

660 Ft. from E. Line

Ft. from W. Line

SECTION PLAT

			o

Location.....

Rig up.....

Drilling and Remarks:

R. O. S.

RECORD

Cased..... in., ft.

Sand.....

Gas.....

Oil.....

Total Depth.....

PRODUCTION

1st 24 hrs. Nat.....

1st 24 hrs. after shot.....

Gas..... Cu. Ft.

Dry Hole.....

Abandoned.....

Date

APR 26 1933

CHAS. L. SHERWOOD

192

Scout

Reno
 Map No. _____ Sec. *24* Twp. *23* R. *4W*
 Well No. *1-Hulchinson Lbr Co*

Olsen-Shell

Company

Contractor

SECTION PLAT

660 Ft. from N. Line

_____ Ft. from S. Line

660 Ft. from E. Line

_____ Ft. from W. Line

COMPLETED

			○
		✱	

Location _____

Rig up _____

Drilling and Remarks:

chat 3265

170 bbls oil

RECORD

Cased _____ in., _____ ft.

Sand _____

Gas _____

Oil _____

Total Depth *3377*

PRODUCTION

1st 24 hrs. Nat. _____

1st 24 hrs. after shot _____

Gas _____ Cu. Ft.

Dry Hole _____

Abandoned _____

Date

6/14/33 192

Oval Manschreck Seal out