



Map No. KANSAS Sec. 24 Twp. 23 R. 4<sup>w</sup>

Well No. 1- Rudicil Farm  
Olsen & Shell Company


\_\_\_\_\_ Ft. from N. Line

660 Ft. from S. Line

\_\_\_\_\_ Ft. from E. Line

660 Ft. from W. Line

1932

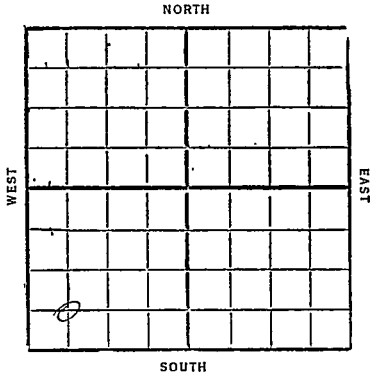

Date	REPORT
6/22	Loc
6/29	Rup
7/6	Cem 15 1/2" - 247
	Dreg 965'
7/13	" 2410'
7/20	" 3030'
7/27	Top chat 3262
	Cem 8" - 3340
	SID 3342
8/3	TD 3374
	1 1/2 hr gas and
	flow 30 to 40 bbl hour
8/10	Cased 8" - 3340
	Chat 3262 - 3374
	TD 3374
	flow 465 bbl 18 hr
	Est. 2 to 3 hr gas
	Comp.

Reno

40 KANSAS W  
Map No. Sec. 24 Twp. 23 R. 4Well No. 1 Rudice  
Olsen & Shell Company

Contractor

## FIRST REPORTS

## SECTION PLAT

.....Ft. from N. Line

660 Ft. from S. Line

.....Ft. from E. Line

660 Ft. from W. Line

0			2

Location..... ✓

Rig up.....

Drilling and Remarks:

## RECORD

Cased..... in., .....ft.

Sand.....

Gas.....

Oil.....

Total Depth.....

## PRODUCTION

1st 24 hrs. Nat.....

1st 24 hrs. after shot.....

Gas..... Cu. Ft.

Dry Hole.....

Abandoned.....

Date

JUN 22 1932 CHAS. L. SHERWOOD  
192 Scout

Reno

40 KANSAS

Map No. \_\_\_\_\_ Sec. 24 Twp. 23 R. 11

Well No. 1

Olsen & Shell Company

Contractor

COMPLETED

SECTION PLAT

\_\_\_\_\_ Ft. from N. Line

660 Ft. from S. Line

\_\_\_\_\_ Ft. from E. Line

660 Ft. from W. Line


Location \_\_\_\_\_

Rig up \_\_\_\_\_

Drilling and Remarks:

Flow 465 Bbls  
18 Hams.

Est 2 to 3 AM

RECORD:

Cased, 8 in., 3340 ft.

Sand Chat 3267-3374

Gas \_\_\_\_\_

Oil \_\_\_\_\_

Total Depth 3374

PRODUCTION

1st 24 hrs. Nat. \_\_\_\_\_

2nd 24 hrs. after shot \_\_\_\_\_

Gas \_\_\_\_\_ Cu. Ft.

Dry Hole \_\_\_\_\_

Abandoned \_\_\_\_\_

Date

AUG 1 0 1932

CHAS. L. SHERWOOD

192

Scout