


Revo

Map No. **KANSAS** Sec. *24* Twp. *23* R. *4W*

Well No. *3- Rudicek* Farm _____
Olson & Shell Company _____

NORTH

14

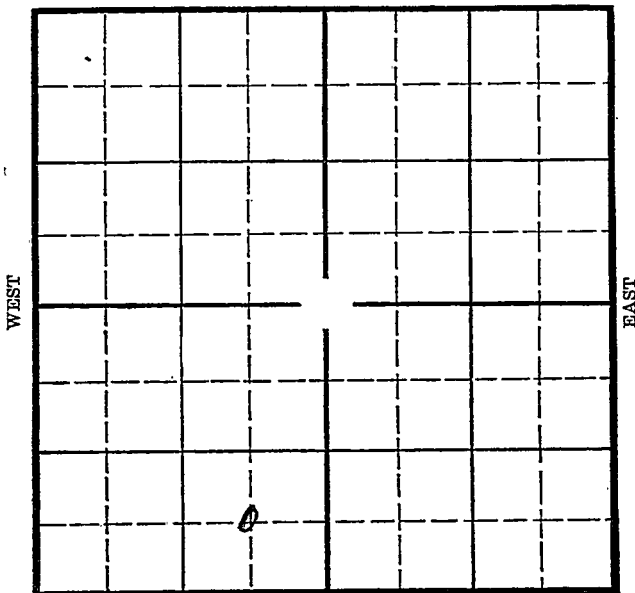

Location _____

Drilling Remarks _____

Rig Up _____

Drilling Remarks _____

RECORD

Cased _____ in. _____ ft.

Sand _____

Gas _____

Oil _____

Total Depth _____

PRODUCTION

1st 24 hrs. Nat. _____

1st 24 hrs. after shot _____

Gas _____ cu. ft. _____

Dry Hole _____

Abandoned _____

WAS

reno

Map No. _____ Sec. 24 Twp. 23 R. 4W

Well No. 3- Rusticel Farm _____

Olson & Shell

Company _____

_____ Ft. from N. Line

660


Ft. from S. Line

660

Ft. from E. Line

_____ Ft. from W. Line

Elev. 1464

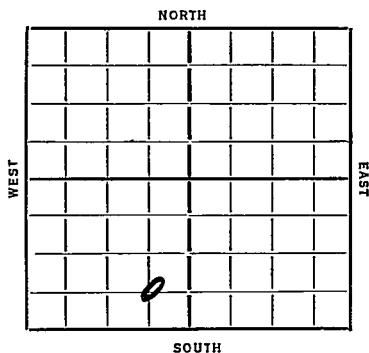

REPORT

~~1946~~
 1/22
 1/31
 2/7
 2/14
 2/21
 2/28
 3/4

1 1/2" 253 WOC
 Plug 1272
 2706
 Chrt 3262 7" 3272 Rust
 Plug plug
 TD 3362 1000 acid
 Chrt 3262
 TD 3362
 1000 acid
 270 Bbls

COMPLETED

LV 15AS

Map No. 40 Sec. 24 Twp. 23 R. 4W

Well No. 3 - Rudical

Alson & Shell Company

Contractor

SECTION PLAT

..... Ft. from N. Line

660 Ft. from S. Line

660 Ft. from E. Line

..... Ft. from W. Line

	o		

FIRST REPORT

Location.....

Rig up.....

Drilling and Remarks:

12" 253 woc

RECORD

Cased..... in., ft.

Sand.....

Gas.....

Oil.....

Total Depth.....

PRODUCTION

1st 24 hrs. Nat.....

1st 24 hrs. after shot.....

Gas..... Cu. Ft.

Dry Hole.....

Abandoned.....

Date

JAN 22 1936 192.....

Scout

ORVAL MANSCHERK

Map No. 40 Sec. 24 Twp. 23 R. 4^W

Well No. 3-Rudical

Olson & Shell Company

Contractor

COMPLETE

SECTION PLAT

.....Ft. from N. Line

660 Ft. from S. Line

660 Ft. from E. Line

.....Ft. from W. Line

	0		

Location.....

Rig up.....

Drilling and Remarks:

1000 acid

220 lbs

RECORD

Cased.....in.,.....ft.

Sand Chat 3267

Gas.....

Oil.....

Total Depth 3367

PRODUCTION

1st 24 hrs. Nat.....

1st 24 hrs. after shot.....

Gas.....Cu. Ft.

Dry Hole.....

Abandoned.....

Date

3-4-36 192.....

ORVAL

15

Scout