


Map No. KANSAS Sec. 24 Twp. 23 R. 4^W

Well No. 1- Cabin Farm
Olsen & Shell Company

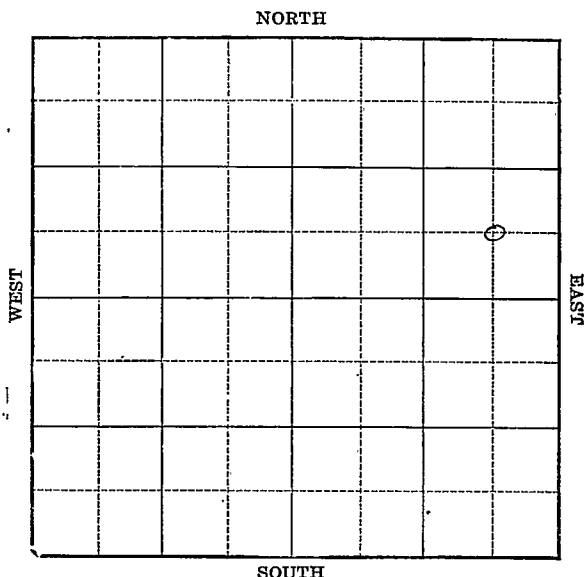

Location _____

Drilling Remarks _____

Rig Up _____

Drilling Remarks _____

RECORD

Cased _____ in. _____ ft.

Sand _____

Gas _____

Oil _____

Total Depth _____

PRODUCTION

1st 24 hrs. Nat. _____

1st 24 hrs. after shot _____


Gas _____ cu. ft.

Dry Hole _____

Abandoned _____

Map No. KANSAS Sec. 24 Twp. 23 R. 4^w
 Well No. 1- Cabin Farm
Olsen & Shell Company

NORTH

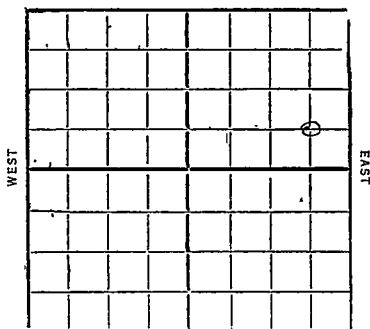

Ft. from N. Line

660 Ft. from S. Line

660 Ft. from E. Line

Ft. from W. Line

1932

Date

REPORT

5/25 Loc
 6/11 Rig
 6/8 Chat pipe 257'
 6/15 Lined 2008
 6/22 " 2920'
 6/29 Top Chat 3264
 Cem 8" 3280'
 7/6 —
 7/13 TD 3372
 Made 1st gas and
 225 bbl oil. 12 hr
 7/19 Cased 8"-3280
 Chat 3264-3372
 TD 3372
 flow 290 bbl 24 hr
 150# back pressure
 1st gas
 Comp.

40 KANSAS

Map No. _____ Sec. 24 Twp. 23 R. 4

Well No. 1 Sabin

Olsen & Shell Company

Contractor

FIRST REPORTS

_____ Ft. from N. Line

660 Ft. from S. Line

660 Ft. from E. Line

_____ Ft. from W. Line

SECTION PLAT

			o

Location ✓

Rig up

Drilling and Remarks:

RECORD

Cased _____ in., _____ ft.

Sand _____

Gas _____

Oil _____

Total Depth _____

PRODUCTION

1st 24 hrs. Nat. _____

1st 24 hrs. after shot _____

Gas _____ Cu. Ft.

Dry Hole _____

Abandoned _____

Date

MAY 25 1932

CHAS. L. SHERWOOD

Scout

40 KANSAS

Map No. _____ Sec. 24 Twp. 23 R. 4 W

Well No. 1 Sabin

Olsen & Shell Company

Contractor

COMPLETED

SECTION PLAT

			0
			1

_____ Ft. from N. Line

660 Ft. from S. Line

660 Ft. from E. Line

_____ Ft. from W. Line

Location _____

Rig up _____

Drilling and Remarks:

Flow 290 Bar
 24 Hrs.
 150 # Back Pressure

RECORD

Cased 8 in., 3780 ft.

Sand Chat 3764-3372

Gas _____

Oil _____

Total Depth 3372

- PRODUCTION

1st 24 hrs. Nat. _____

1st 24 hrs. after shot _____

Gas 14 Cu. Ft.

Dry Hole _____

Abandoned _____

Date

JUL 20 1932

CHAS. L. SHERWOOD

192

Scout