

Reno


KANSAS

SECTION 24 TOWNSHIP 23 RANGE 9 W

WELL NO. #1 Beck

COMPANY Ambassador Oil Corp.

NORTH

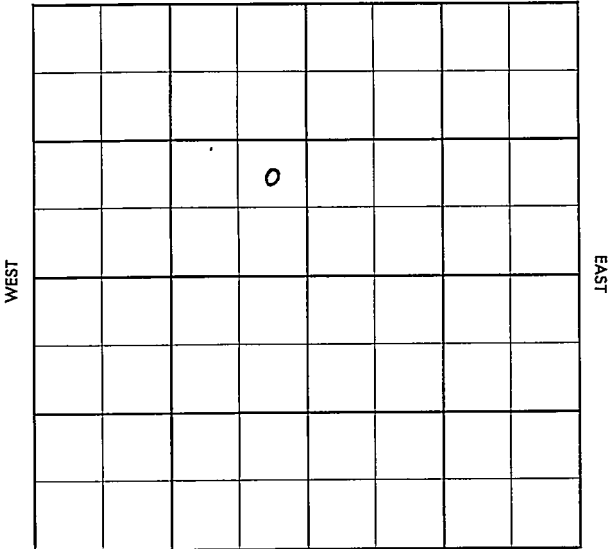

SOUTH

KANSAS

R.

9W

#1 Beck

FARM

COMPANY

Ambassador Oil Corp

CONTRACTOR

Garvey

Beck


Ft. from N. Line

Ft. from S. Line

Ft. from E. Line

Ft. from W. Line

NE SE NW

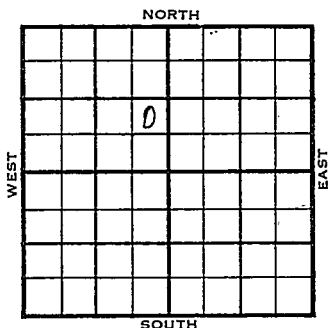

1956

ELEVATION

REPORT

2-1

Dr1g. 1849

County Reno Elev. _____
Sec. 24 Twp. 23 Rge. 9W
Company Ambassador Oil Corp.
Farm Name Beck No. 1


TOPS	DEPTH	LOG	DATUM
Anh.			
Tr.			
H.			
Tr.			
Dg.			
BL.			
L.			
K.C.			
B.K.C.			
Ce.			
C.			
M.			
M.			
K.			
Mz.			
Ma.			
V.			
S.			
S.			
A.			
R.			
Pe.			
G.			
T.D.			

Loc. in Sec. NE SE NW
Geol. _____
Contr. _____
Garvey
Pool Beck

FEB 1	1956
o	

FIRST REPORT

Date Comm. drlg. 1849

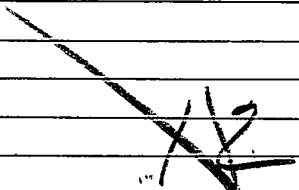

County Reno Elev. 1701
 Sec. 24 Twp. 23 Rge. 9W
 Company Ambassador Oil Corp.
 Farm Name Beck No. 1

TOPS	DEPTH	LOG	DATUM	Loc. in Sec.
Ank.				NE SE NW
Tr.				
H.	3040	3056		
Dr.				
BL.	3213	3214	1512	
L.	3240	3240	1539	Geol.
K.C.		3598	1897	Contr.
B.K.C.				
Ce.		3686	1985	Garvey
C. <u>shly</u>		3703	2001	
M. <u>cg chert</u>		3746	2045	Pool
M. <u>155</u>				Beck
K.				
Mz.				
Mo.				
V.				
S.				
S.				
A.				
R.				
PE.				
G.				
TD	3760			

Date Comm. (TD 3760) FEB 15 1956
 drlg. 1849 FEB 8 56 1-28-56

8⁵/₈ 125 DST 3704-11 lhr
 see 15' Md BHP 0 @ 3720
 FEB 15 '56 DST 3713-20 lhr see
 461' GIP see 30' 0 CM + 90'
 954 wte FP 50-120 BHP
 1360/20 DST 3725-35 lhr
 see 170' G & 0 CWM + 960' 50 CWM
 FP 70-470 BHP 1310/20 2050

ABANDONED