


Section 24 Township 23 Range 13 W

Well No. # 1 Smolick (Smolik)

Company M. B. Armer

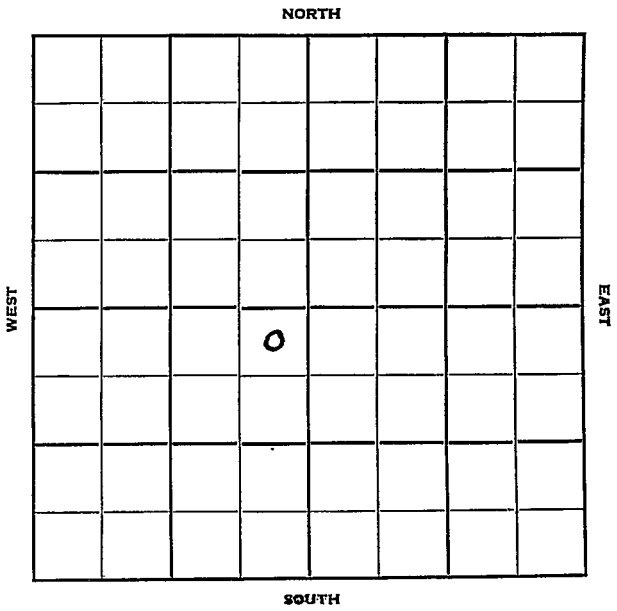

Stafford

KANSAS

Sec. 24 Twp. 23 R. 13W

Well No. #1 Smolick Farm

M. B. Armer Company

Armer - Contr. Contractor

Wildcat


330' Ft. from N. Line

Ft. from S. Line

330' Ft. from E. Line

Ft. from W. Line

NE NE SW

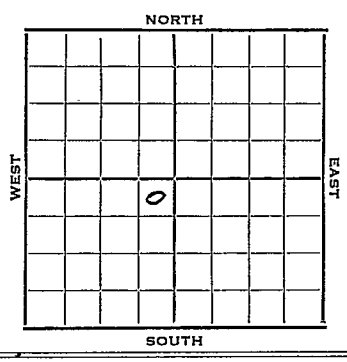

1952 Elev. 1879' REPORT

3/23

8" @ 294
Drlg. 525'

4/1

Heeb 3292' Tor 3309' Br li 3428'
Lans. 3454'
Dr.g 3729'

4/9

Spud 3-23-52
D&A TD 3969
8" @ 294 Heeb. 3292
Tor. 3309 Br lime 3428
Lans. 3454 Viola 3786
Simp 3858 Arb. 3918 TD 3969
D&A

ABANDONED

County **Stafford** State **Kansas**

Sec. **24** (Blk. **23**) (Sur. **13W**) Map No.

Operator **M. B. Armer**

Well No. **1** Farm **Smolick**

Elev. Location **NE NE SW**

FIRST REPORT

330 Ft. From **N** Line **SW**

330 Ft. From **E** Line Quarter

Ist. Report **MAR 26 1952**

Completion

Remarks **Skelly - DEM Magnolia**

Armer - Contr. F. O.

Spudding Date **3-23-52.**

Drlg. Data **Wildcat**

8" @ 294 Drlg. 525

