


Section 24 Township 23 Range 11W
Well No. 1 Radke
Company Harms & Burt Drlg.

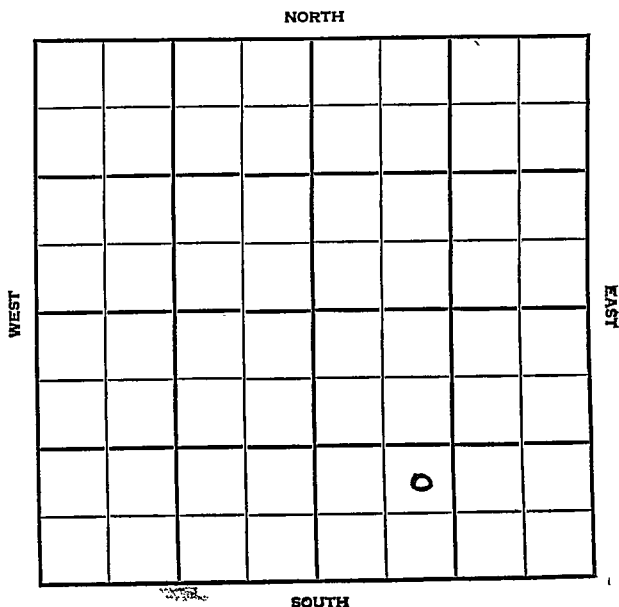

Stafford

KANSAS

SEC.	TWP.	R.
24	23	14W

WELL NO.

#1 Radke FARM

COMPANY

Harms & Burt Drlg.

CONTRACTOR

Co. Tools.

Radke Pool

Ft. from N. Line

990


Ft. from S. Line

Ft. from E. Line

990


Ft. from W. Line

NE SW SE
Lindas F/O

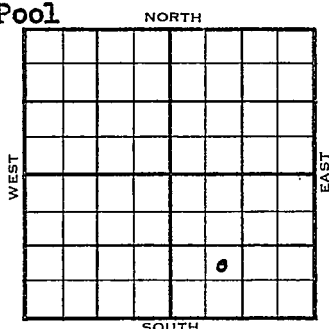

1954	ELEVATION	REPORT
	1940'	
9/8	Location	
11/23	Spud 9-8-54	
	Oil Well	
	TD 4065'	
	8" @ 207'	
	Anhy 840', Lans 3551'	
	DST 3588'-3600' opn 45 min, rec 28' soc	
	1040#	
	DST 3614'-25' opn 1 hr, rec 20' ocm,	
	60' s.w. 764#	
	DST 3670'-86' opn 1 hr, rec 60' ocm	
	120' oil 1170#	
	DST 3690'-3708' opn 1 hr, rec 64' Muddy	
	S.W. 675#	
	DST 3714'-26' opn 1 hr, rec 30' wcm	
	1310#	
	Viola 3898'	
	Arb. 4023	
	TD 4065'	
	5" @ 3730'	
	CO to 3691 16/ 3676-80 1000 A S/ 2 to	
	3 boph P/ 155 bo 24 hr.	
	Comp 161 bopd.	

COMPLETED

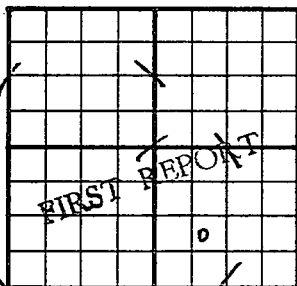County Stafford State KansasSec. 24 (Blk. Twp.) 23 (Sur. Rge.) 14W Map No.Operator Harms & Burt Drlg.Well No. 1 Farm RadkeElev. Location NE SW SE990 Ft. From S Line SE990 Ft. From W Line Quarter1st. Report SEP 8 1954


Completion

Remarks Lindas farmoutCo. tools

Spudding Date

Drlg. Data Radke PoolLocation

FABEN GILSTRAP

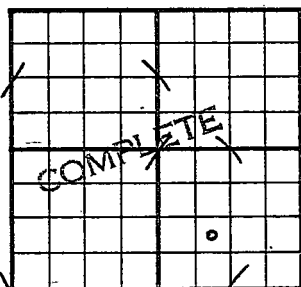County Stafford State KansasSec. 24 (Blk.) 23 (Sur.) 14W Map No.Operator Harms & Burt Drlg.Well No. 1 Farm RadkeElev. 1940 Location NE SW SE990 Ft. From S Line SE990 Ft. From W Line Quarter

1st. Report

Completion NOV 23 1954Remarks Radke PoolCo. toolsSpudding Date 9-8-54Drlg. Data Oil well TD 40658" @ 207 Anhy 840 Lans. 3551DST 3588-3600 open 45 min. Rec. 28' socm1040# DST 3614-25 open 1 hr. Rec. 20'ocm 60' sw 764# DST 3670-86open 1 hr. Rec. 60' ocm 120' oil1170# DST 3690-3708 open 1 hr.Rec. 64' muddy sw 675# DST 3714-26open 1 hr. Rec. 30' wcm 1310#Viola 3898 Arb. 4023 TD 40655" @ 3730 CO to 3691 16/ 3676-801000 A S/ 2 to 3 boph P/-155-bo 24 hr.Comp. 161 bopd

FABEN GILSTRAP