

Pawnee

KANSAS

SECTION 24 TOWNSHIP 23 RANGE 18W

WELL NO. #1 Smith

COMPANY Honaker-Davis

NORTH NE NE NE

|       |  |  |  |  |  |  |   |      |
|-------|--|--|--|--|--|--|---|------|
| WEST  |  |  |  |  |  |  | 0 | EAST |
|       |  |  |  |  |  |  |   |      |
|       |  |  |  |  |  |  |   |      |
| SOUTH |  |  |  |  |  |  |   |      |

Pawnee

KANSAS

|      |      |      |
|------|------|------|
| SEC. | TWP. | R.   |
| 24   | 23 S | 18 W |

WELL NO.

# 1 Smith

FARM

COMPANY

Honaker-Davis

CONTRACTOR

Honaker-Davis


Wildcat

\_\_\_\_ FT. FROM N. LINE

\_\_\_\_ FT. FROM S. LINE

\_\_\_\_ FT. FROM E. LINE

\_\_\_\_ FT. FROM W. LINE

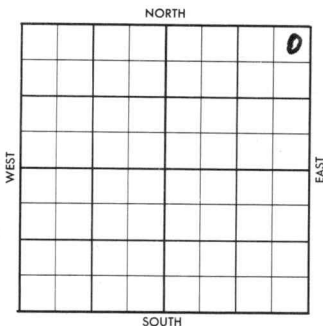

NE NE NE

Sohio-AC

SDX-1/2 Mile

ELEVATION

REPORT

1957

2/6

Spud 2-2-57  
8" @ 250/175  
Drlg. 2275'

(FR Tkt)

21 B-0

# WILDCAT

FORM 513 SUNRAY

County Paynee Elev. \_\_\_\_\_  
 Sec. 24 Twp. 23 Rge. 18W  
 Company Honaker-Davis  
 Farm Name Smith No. 1

| TOPS   | DEPTH | LOG | DATUM | Loc. in Sec.         |
|--------|-------|-----|-------|----------------------|
| Anh.   |       |     |       | NE NE NE             |
| Tp.    |       |     |       |                      |
| H.     |       |     |       |                      |
| Tr.    |       |     |       |                      |
| Dg.    |       |     |       |                      |
| BL.    |       |     |       |                      |
| L.     |       |     |       | Geol.                |
| K.C.   |       |     |       | Contr.               |
| B.K.C. |       |     |       | <u>Honaker-Davis</u> |
| Ce.    |       |     |       | Pool                 |
| C.     |       |     |       | <u>Wildcat</u>       |
| M.     |       |     |       |                      |
| M.     |       |     |       |                      |
| K.     |       |     |       |                      |
| Mz.    |       |     |       |                      |
| Mq.    |       |     |       |                      |
| V.     |       |     |       |                      |
| S.     |       |     |       |                      |
| S.     |       |     |       |                      |
| A      |       |     |       |                      |
| R.     |       |     |       |                      |
| PE.    |       |     |       |                      |
| G.     |       |     |       |                      |
| T.D.   |       |     |       |                      |

|              |  |
|--------------|--|
| FIRST REPORT |  |
| 1/2 mile     |  |
| FEB 6 '57    |  |

Date Comm. 2-2-57 Sohio - AC  
8" @ 250/175 drlg. 2275

~~A~~

LED 0 1021

M.M

County Pawnee Elev. 2094  
 Sec. 24 Twp. 23 Rge. 18W  
 Company Honaker-Davis  
 No. 1  
 Smith

|             | DEPTH | LOG  | DATUM | Loc. in Sec.  |
|-------------|-------|------|-------|---------------|
|             |       |      |       | NE NE NE      |
| Tp.         | 3698  | 3700 |       |               |
| H.          |       |      |       |               |
| Tr.         |       |      |       |               |
| Dg.         |       |      |       |               |
| Bl.         |       | 3806 |       |               |
| L.          | 3814  | 3816 |       |               |
| K.C.        |       |      |       | Geol.         |
| B.K.C.      |       |      |       | Contr.        |
| Ce.         |       |      |       | Honaker-Davis |
| C. shly     | 4253  | 4256 |       |               |
| M. c9 chert | 4268  | 4271 |       |               |
| M.          |       |      |       | Pool          |
| K.          |       |      |       | Wildcat       |
| Mz.         |       |      |       |               |
| Mo.         |       |      |       |               |
| V.          | 4434  |      |       |               |
| S.          |       |      |       |               |
| S.          |       |      |       |               |
| A.          |       |      |       |               |
| R.          |       |      |       |               |
| PE.         |       |      |       |               |
| G.          |       |      |       |               |
| TD.         | 4434  | 4439 |       |               |

ABANDONED

1/2 mile

FEB 20 '57

Date Comm. 2-2-57 Sohio - AC

8" @ 250/175 drlg. 2275 FEB 13 '57

① 4025 FEB 20 '57 DST 4251-78

90" 300' GAS + 130' MOE'GCM

BHP 310 FPO DST 4279-97

1hr 2760' GCSW (scum oil) FP

580-1240 BHP 1240

D.E.A.