


Section 24 Township 23 Range 24 WWell No. # 1 RaserCompany Jarbo Commission

NORTH

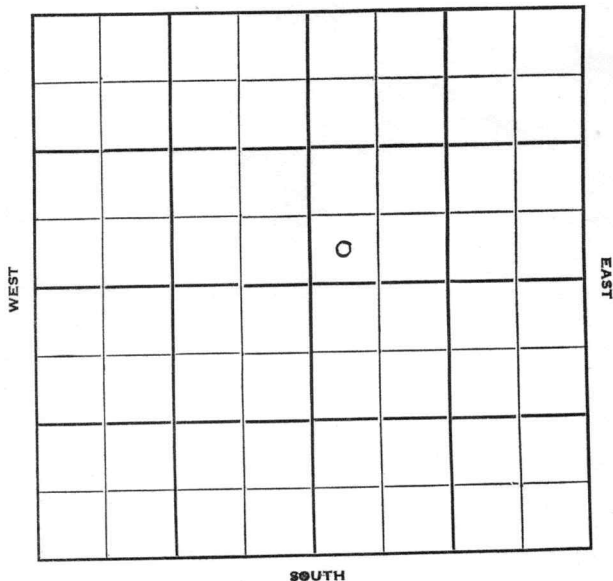

Hodgeman

KANSAS

Sec. 24 Twp. 23 R. 24W

Well No. #1 Raser Farm

Jarbo Commission Company

Berwick Contractor

Wildcat


 Ft. from N. Line

330' Ft. from S. Line

 Ft. from E. Line

330' Ft. from W. Line

SW SW NE

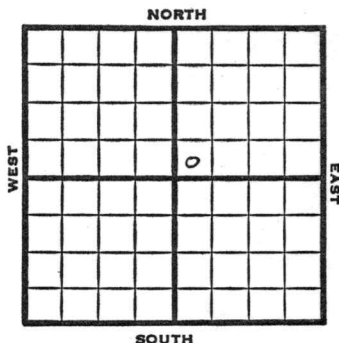

1951

Elev. 2428'

REPORT

5/9

Location

6/20

Spud 5-29-51

D & A TD 4810' 8" @ 190


Lans. 4090' Heeb 4008' B KC 4306'

Miss. 4751' SO 4751-58'

DST 4751-92 rec 2630' water TD 4810'

D & A

ABANDONED

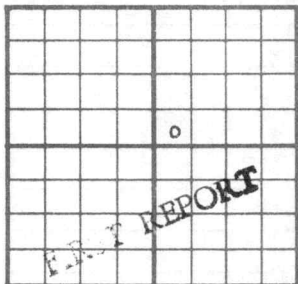County Hodgeman State KansasSec. 24 (Blk. Twp.) 23 (Sur. Rge.) 24W Map No.Operator Jarbo CommissionWell No. 1 Farm RaserElev. _____ Location SW SW NE330 Ft. From S Line NE330 Ft. From W Line Quarter1st. Report MAY 9 1951


Completion _____

Remarks _____

Spudding Date _____

Drlg. Data WildcatLocation

J. E. TYRA

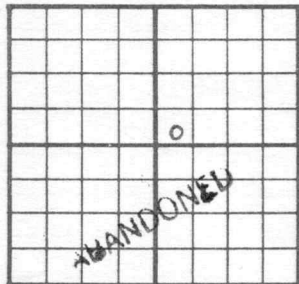County Hodgeman State KansasSec. 24 (^{Blk.}_{Twp.}) 23 (^{Sur.}_{Rge.}) 24W Map No.Operator Jarbo CommissionWell No. 1 Farm RaserElev. 2428 Location SW SW NE330 Ft. From S Line NE330 Ft. From W Line Quarter

1st. Report

Completion JUN 20 1951Remarks WildcatBerwick - Contr.Spudding Date 5-29-51Drlg. Data D & A TD 48108" @ 190 Lans. 4090 Heeb. 4008B KC 4306 Miss. 4751 SO 4751-58DST 4751-92 Rec. 2630' water TD 4810D & A

J. E. TYRA