


Finney

KANSAS

Section 24 Township 23 Range 30W

Well No. #1 Pitson

Company W. A. Delaney et al

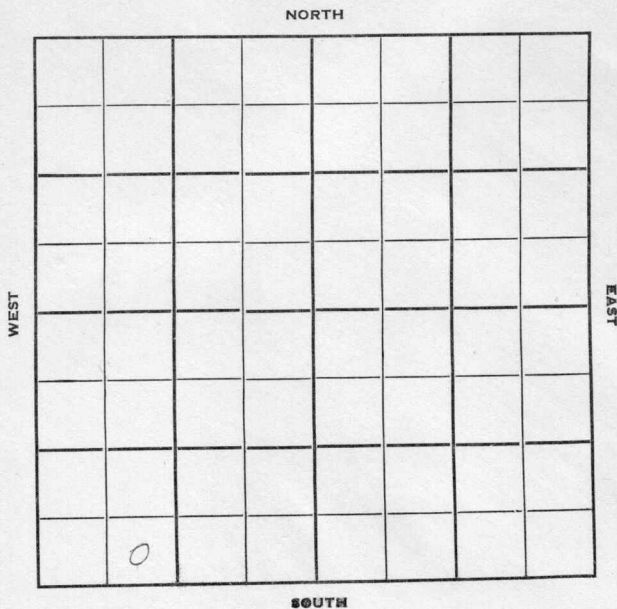

Finney

KANSAS

30W ✓

Sec. 24 Twp. 23 R. 30W

Well No. #1 Pitson Farm

W. A. Delaney et al Company

Contractor

Wildcat


Ft. from N. Line

330' Ft. from S. Line

Ft. from E. Line

990' Ft. from W. Line

SE SW SW

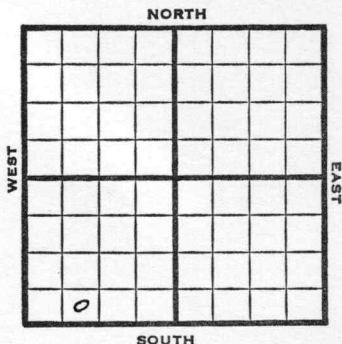

1950

Elev 2790' REPORT

4/12

Miss test

5/3

Drlg. 1500'

TD 4870'

Ft Riley 2715'

Heeb 4016'

KC 4063'

Miss 4762'

D&A


Aband.

ABANDONED

Kansas

Map No. _____ Sec. 24 Twp. 23 R. 30WWell No. 1 PitsonW. A. Delaney et al. Company~~SE SW~~ ContractorNW NE SW

SECTION PLAT

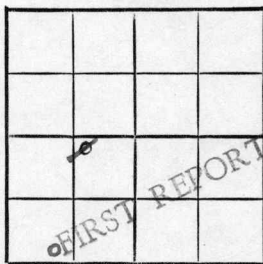~~550~~ Ft. from N. Line330 Ft. from S. Line~~990~~ Ft. from E. Line990 Ft. from W. Line

Finney County

Location _____

Rig up _____

Drilling and Remarks:

Miss. test

drlg. 1500

RECORD

Cased _____ in., _____ ft.

Sand _____

Gas _____

Oil _____

Total Depth _____

PRODUCTION

1st 24 hrs. Nat. _____

1st 24 hrs. after shot _____

Gas _____ Cu. Ft.

Dry Hole _____

Abandoned _____

Date

APR 12 1950

19

J. E. TYRA Scout

Kansas

Wildcat

Map No. _____ Sec. 24 Twp. 23 R. 30WWell No. 1 PitsonW. A. Delaney et al. Company

Contractor

SE SW SW

E1. 2790
SECTION PLAT

_____ Ft. from N. Line

330 _____ Ft. from S. Line

_____ Ft. from E. Line

990 _____ Ft. from W. Line

Finney County

Location _____

Rig up _____

Drilling and Remarks:

H. Riley 2715
 Hebl 4016
 K.C. 4063
 Miss 4762
 D & A

RECORD

Cased _____ in., _____ ft.

Sand _____

Gas _____

Oil _____

Total Depth 4870

PRODUCTION

1st 24 hrs. Nat. _____

1st 24 hrs. after shot _____

Gas _____ Cu. Ft.

Dry Hole _____

Abandoned _____

Date

MAY 3 1950

19

J. E. TYDA

Scout