


SECTION 24 TOWNSHIP 23 RANGE 32W

WELL NO. #1 Brinkmeyer

COMPANY Petroleum Inc.

NORTH C SE/4

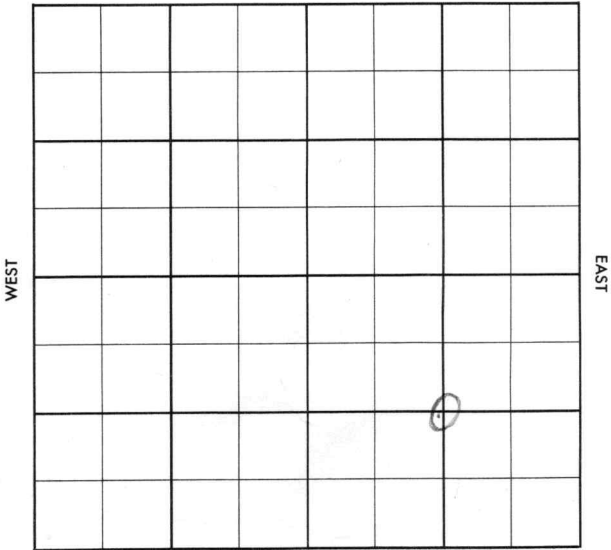

SOUTH

County Finney Elev. \_\_\_\_\_  
 Sec. 24 Twp. 23 Rgs. 32W  
 Company Petroleum Inc.  
 Farm Name Brinkmeyer No. 1

TOPS	DEPTH	LOG	DATUM
Anh.			
Tp.			
H.			
Tr.			
Dg.			
Bl.			
L.			
K.C.			
B.K.C.			
Ce.			
C.			
M.			
M.			
K.			
Mz.			
Mq.			
V.			
S.			
S.			
A			
R.			
Pc.			
G.			
T.D.			

Loc. in Sec. C SE/4  
 Geol. \_\_\_\_\_  
 Contr. Garvey Drlg.  
 Pool Hugoton  
 JUL 3 1957  
 FIRST REPORT

Date Comm. 6-29-57  
8" @ 328/200, Drlg. 2520

*35*

Co.  
Lse.  
No.  
Sec.  
T.  
R.

County Finney Elev. 2927 DE  
 Sec. 24 Twp. 23 Rge. 32W  
 Company Petroleum Inc.  
 Farm Name Brinkmeyer No. 1

TOPS	DEPTH	LOG	DATUM
Anh.			
Tp. <u>Herr</u>		<u>2676</u>	
H. <u>Kri</u>		<u>2702</u>	
Tr.			
Dg.			
Bl.			
L.			
K.C.			
B.K.C.			
Ce.			
C.			
M.			
M.			
K.			
Mz.			
Ma.			
V.			
S.			
S.			
A.			
R.			
Pe.			
G.			
T.D.	<u>2720</u>		

Loc. in Sec. C SE/4

Geol. \_\_\_\_\_

Concr. \_\_\_\_\_

Garvey Drlg. \_\_\_\_\_

Pool \_\_\_\_\_

Hugoton

AUG 22 '57	
COMPLETE	●

Date Comm. 6-29-57

8" @ 328/200, Drlg. 2520 <sup>MIL 10 '57</sup> 9 1/2 2719

11050 <sup>JUL 17 '57</sup> CO 2720 24/2680

-88 1/2 ga 140 MCF/plus + spray

w/ Frac ReFF 2680-88 Frac

5 1/2 x 5 1/2 ga 3,453 MCF + 3 1/2

Bwph <sup>JUL 24 '57</sup> ga 2,909 MCF + 1

Bwph <sup>JUL 31 '57</sup> <sup>AUG 8 '57</sup> <sup>AUG 14 '57</sup> <sup>AUG 21 '57</sup> 72.20

9,630 MCF CIP 391.6 PBTD 2696

PF 2680-88