

Finney


KANSAS

SECTION 24 TOWNSHIP 23 RANGE 32W

WELL NO. #1 Hibbert

COMPANY Colo. O&G, Ohio & Graham-Michaelis

NORTH C SW/4

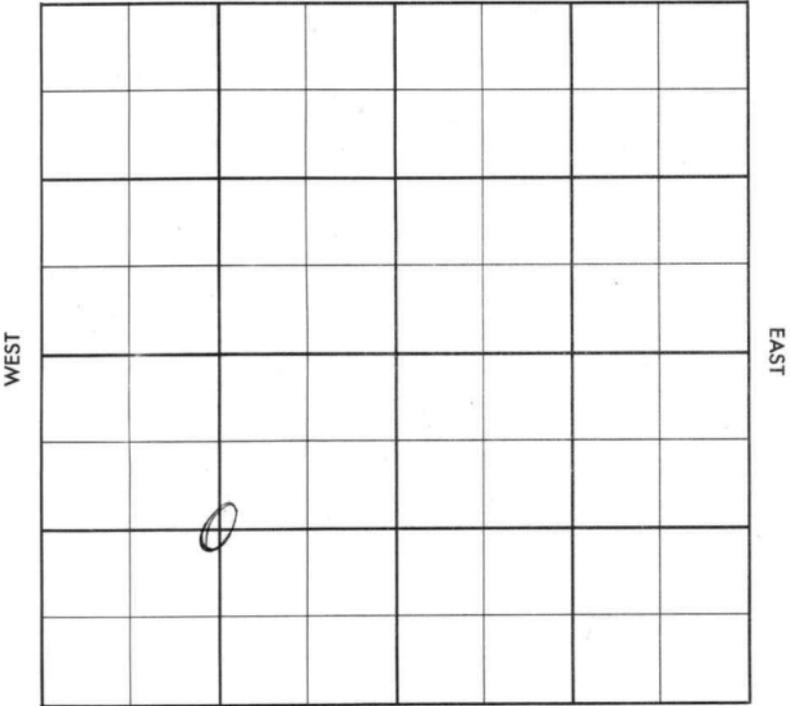

SOUTH

County Finney Elev. _____
 Sec. 24 Twp. 23 Rge. 32W
 Company Colo. O & G, Ohio & Graham-Michaelis
 FarmName Hibbert No. 1

TOPS	DEPTH	LOG	DATUM
Anh.			
Tr.			
H.			
Tr.			
Dg.			
Bl.			
L.			
K.C.			
B.K.C.			
Ce.			
C.			
M.			
M.			
K.			
Mz.			
Me.			
V.			
S.			
S.			
A.			
R.			
PE.			
G.			
T.D.	<u>2735</u>		

Loc. in Sec. C SW/4
 Geol. _____
 Contr. _____
Co. tools
 Pool _____



Date Comm. 2-7-57
8" @ 506/300 4" @ 2731/200

35

Co.
Lse.
No.
Sec.
T.
R.

County Finney Elev. 2917
 Sec. 24 Twp. 23 Rge. 32W
 Company Goio, G & G, Ohio & Graham-Michaelis
 Farm Name Hibbert No. 1

TOPS	DEPTH	LOG	DATUM	Loc. in Sec.
Ans.				C SW/4
Tp. <u>OKFI</u>		<u>2663</u>		
H. <u>L KFI</u>		<u>2693</u>		
Tr.				
Dg.				
Bl.				
L.				Geol. _____
K.C.				Contr. _____
B.K.C.				
Ce.				Co. tools
C.				
M.				Pool
M.				
K.				
Mz.				
Mo.				
V.				
S.				
S.				
A.				
R.				
PE.				
G.				
TD.		<u>2735</u>		

COMPLETE	
MAR 20 '57	

Date Comm. 2-7-57
8" @ 506/300 4" @ 2731/200 FEB 20 '57
MILT 32/2666-74 48/2692-2704
17 Frac FEB 27 '57 ga 3 MILL CFE
+ 1 DWPH 5ad. 32/2666-74
1 ga 1 1/2 MILL CFE 3 Frac
MAR 6 '57 ga 1.940 MCFG wo. 72-20
MAR 13 '57 MAR 20 '57 72-20 5,820 mefg