


Section 24 Township 23 Range 34W

Well No. 8 Garden City Co.

Company Northern Pump

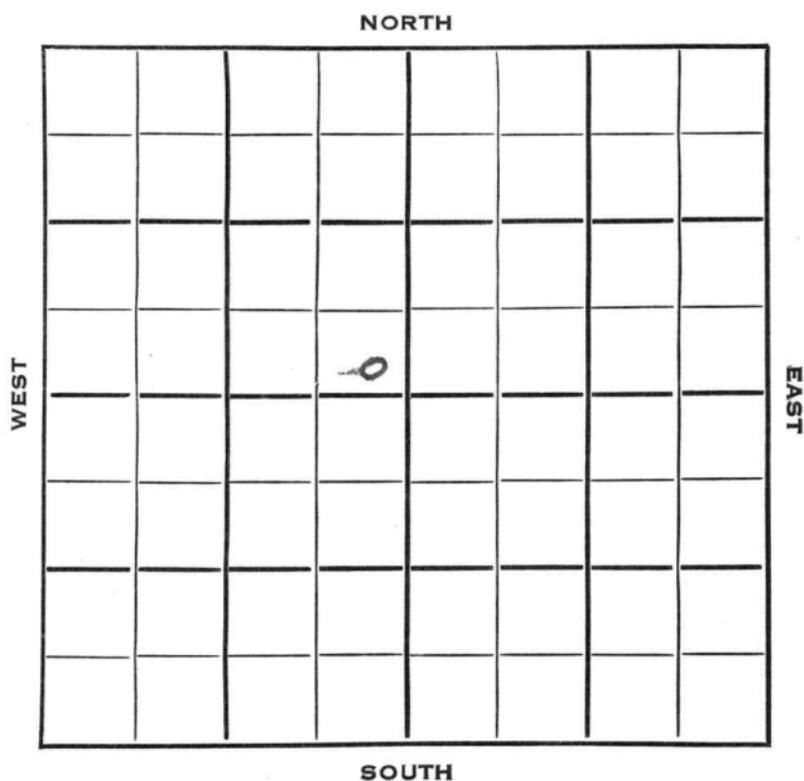

Finney KANSAS

SEC. 24	TWP. 23	R. 34W
------------	------------	-----------


WELL NO. 8 Garden City Co. FARM

COMPANY
Northern Pump

CONTRACTOR

Hugoton Pool

_____ Ft. from N. Line
 200 _____ Ft. from S. Line
 200 _____ Ft. from E. Line
 _____ Ft. from W. Line

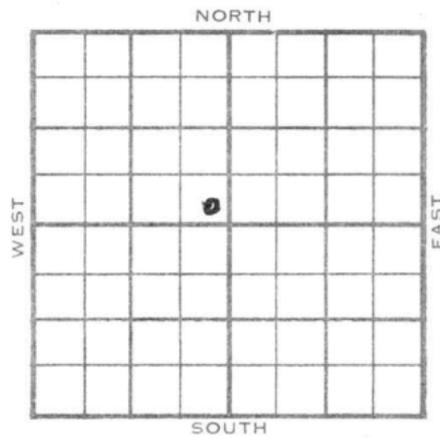

SE SE NW
Stanolind F/O

	ELEVATION	REPORT
1954	2913'	
5/5	Spud 4-29-54 10" @ 365' Drlg. 2355'	
5/12	RTD 2625' 7" @ 2620' Her. 2450', Kr. 2467', Win 2506' Tow 2562', Ft Riley 2619'	
5/19	WOCT.	
5/26	CO 2617'	
6/15	Spud 4-29-54 Gas well TD 2630 10" @ 365' Her. 2450 Kri. 2467 Win. 2506' Tow. 2562 Ft. Riley 2619' TD 2625 7" @ 2620 CO to 2617 DD 2630 64/2562-78 72/2582-94 24/2598-2604 frac. 5 MCFG 8 hr. SP 2536 88/2506-28 56/2468-82 40/2450-60 62,000 gas frac. 5,800,000 gas. Comp. 12,852,000 CFGPD 410#	

COMPLETED

