


Reno

Map No. KANSAS Sec. 25 Twp. 23 R. 4^W

Well No. 2 Fast Farm
Olsen & Shell Company

_____ Ft. from N. Line
660 Ft. from S. Line
_____ Ft. from E. Line
660 Ft. from W. Line

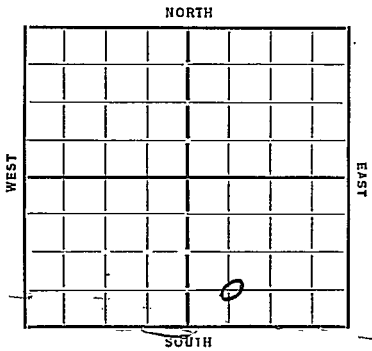

Date

REPORT

1934
9/5 Location
9/13 Rig
9/20 — 9/27 —
10/4 Rig
10/11 Dlg 1950 15 1/2 150
10/18 " 2920
10/25 Chat 3264 8" 3284 Rust
11/1 — 11/8 —
11/15 Oil 3323 Inc 3328 Inc oil
3363-70 HFO 8 hrs.
11/21 Chat 3264 T7 3370
272 oil 15 Water

COMPLETED

KANSAS

Map No. 40 Sec. 25 Twp. 23 R. 4W

Well No. 2 Fast

Olsen + Shell Company

Contractor

SECTION PLAT

FIRST REPORTS

_____ Ft. from N. Line

660 Ft. from S. Line

_____ Ft. from E. Line

660 Ft. from W. Line

		0	

Location ✓ RAM

Rig up _____

Drilling and Remarks:

RECORD

Cased _____ in., _____ ft.

Sand _____

Gas _____

Oil _____

Total Depth _____

PRODUCTION

1st 24 hrs. Nat. _____

1st 24 hrs. after shot _____

Gas _____ Cu. Ft.

Dry Hole _____

Abandoned _____

Date

9-5-37 19

ORVAL MANNSCHRECK

Scout

Map No. 40 Sec. 25 Twp. 23 R. 4W

Well No. 2 - Fast

Olsen + Shell Company

Contractor

COMPLETED

SECTION PLAT

		0	

Ft. from N. Line

660 Ft. from S. Line

Ft. from E. Line

660 Ft. from W. Line

Location.....

Rig up.....

Drilling and Remarks:

272 oil
15 water

RECORD

Cased..... in. ft.

Sand Chat 3264

Gas.....

Oil.....

Total Depth 3370

PRODUCTION

1st 24 hrs. Nat.....

1st 24 hrs. after shot.....

Gas..... Cu. Ft.

Dry Hole.....

Abandoned.....

Date

ORVAL MANNSCHRECK

11-21-37 192

Scout