

Map No. KANSAS Sec. 25 Twp. 23 R. 4

Well No. 3-7 act Farm Alsen Oil Co. Company

NORTH

2

WEST

EAST

SOUTH

Location

Drilling Remarks

Rig Up

Drilling Remarks

RECORD

Cased _____ in. _____ ft.

Sand _____

Gas _____

Oil _____

Total Depth _____

PRODUCTION

1st 24 hrs. Nat. _____

1st 24 hrs. after shot _____

Gas _____ cu. ft. _____

Dry Hole _____

Abandoned _____

Reno

Map No. 25 Sec. 23 Twp. 4W R. 4W
Well No. 3-7ut Farm Olson Oly Co. Company


660 Ft. from N. Line

_____ Ft. from S. Line

_____ Ft. from E. Line

660 Ft. from W. Line

Elev. 1462

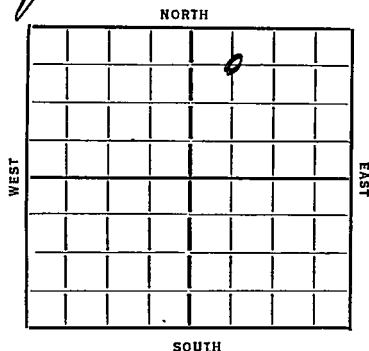

Date 1935 REPORT

12/23 M & Material
12/36 Rgn
1/10 12" 250 10" 490
1/17 12" 2489
Top Chat 3269 7" 3279
TD 3281 WOC
1/24 Railing
1/31 40' g 3344 & 3359-65
TD 3366 Pump tubing
2/7 TD 3366 1000 acid
4/12 Chat 3269
TD 3366
1000 acid
185 lbs.

COMPLETED

Map No. 48 Sec. 25 Twp. 23 R. 4W

Well No. 3-First

Olsen Hdg Co Company

Contractor

SECTION PLAT

660 Ft. from N. Line

..... Ft. from S. Line

..... Ft. from E. Line

660 Ft. from W. Line

Location.....

Rig up.....

Drilling and Remarks:

*Moving in
material*

RECORD

Cased.....in.,ft.

Sand.....

Gas.....

Oil.....

Total Depth.....

PRODUCTION

1st 24 hrs. Nat.....

1st 24 hrs. after shot.....

Gas.....Cu. Ft.

Dry Hole.....

Abandoned.....

Date

ORVAL MANNSCHRECK

12-23-35 192.....

Scout

Map No. *40* Sec. *25* Twp. *23* R. *4W*Well No. *3-First**Olsen Hleg Co* Company

Contractor

COMPLETE*660* Ft. from N. Line

Ft. from S. Line

Ft. from E. Line

660 Ft. from W. Line

SECTION PLAT

		<i>0</i>	

Location

Rig up

Drilling and Remarks:

*1000 acid**185 bbls*

RECORD

Cased *in.* ft.Sand *Chat 3269*

Gas

Oil

Total Depth *3366*

PRODUCTION

1st 24 hrs. Nat.

1st 24 hrs. after shot

Gas Cu. Ft.

Dry Hole

Abandoned

Date

2-12-36 192 *Orval M* Scout*SPB*