


Map No. **KANSAS** Sec. **25** Twp. **23** R. **4W** *Reno*
 Well No. **6- Roberts** Farm
Olson & Shell Company

NORTH

WEST

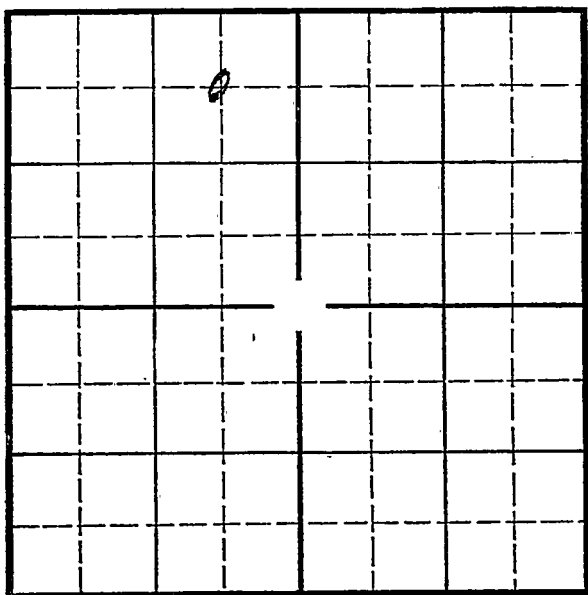

EAST

SOUTH

Location _____
 Drilling Remarks _____

Rig Up _____
 Drilling Remarks _____

RECORD

Cased _____ in. _____ ft.
 Sand _____
 Gas _____
 Oil _____
 Total Depth _____

PRODUCTION

1st 24 hrs. Nat. _____
 1st 24 hrs. after shot _____
 Gas _____ cu. ft. _____
 Dry Hole _____
 Abandoned _____

KANSAS

Reno 4th

Map No. _____ Sec. 25 Twp. 23 R. _____

Well No. 6- Roberts Farm _____

Olsen & Shell

Company _____

660


Ft. from N. Line

Ft. from S. Line

660

Ft. from E. Line

Ft. from W. Line

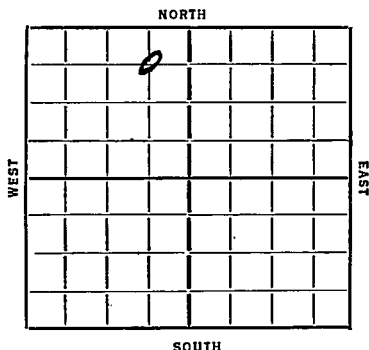

Date

REPORT

1935
10/24 Cellar
11/1 M. J. put
11/7 Spun
11/14 dly 1400 15" 225
11/21 " 2526
11/29 " 3250
12/6 12" 517 Top Chert 3251
dly 3438
12/13 Top Hutton 3634 7" 3630
1" Act Core ~~3634~~ - 3634-35 Rust
12/19 TD 3641 HFW PB to Chert
12/24 PB 3636 7" 3634 Rust
12/30 HFW 3641 TD S.D.
1/10 PB to Chert
Ripped pipe 3330-65
1000 acid
1/17 _____
1/24 pumping wte No Oil
1/31 _____
2/7 PB 3350 Recw 7" woc
2/14 _____ 2/21-
2/28 TD 3364 Intg

OVER

3/6 Pot 42 Bbls
will retent

3/11 Chat 3251
Hinton 3634
TD 3641
PB 3350
TD 3364
1000 acid
42 Bbls.

COMPLETED

Map No. 40 Sec. 25 Twp. 23 R. 4WWell No. 6-150 RobertsOlson & Shell Company

Contractor

FIRST REPORTS

SECTION PLAT

660 Ft. from N. Line

Ft. from S. Line

660 Ft. from E. Line

Ft. from W. Line

	0		

Location.....

Rig up.....

Drilling and Remarks:

cellar

RECORD

Cased.....in.,ft.

Sand.....

Gas.....

Oil.....

Total Depth.....

PRODUCTION

1st 24 hrs. Nat.....

1st 24 hrs. after shot.....

Gas.....Cu. Ft.

Dry Hole.....

Abandoned.....

Date

ORVAL MANNSCHRECK

10-24-35 192

Scout

KANSAS

Map No. 40 Sec. 25 Twp. 23 R. 4WWell No. 6-RobertsOlson & Shell Company

Contractor

COMPLETE

SECTION PLAT

660 Ft. from N. Line

Ft. from S. Line

660 Ft. from E. Line

Ft. from W. Line

	0		

Location

Rig up

Drilling and Remarks:

PB 3350
TN 3364
1000 and
42 bbls

RECORD

Cased in. ft.Sand chat 3251Gas Hinton 3634

Oil

Total Depth 3641

PRODUCTION

1st 24 hrs. Nat.

1st 24 hrs. after shot

Gas Cu. Ft.

Dry Hole

Abandoned

Date

ORVAL MANNSCHRECK

3-11-36 192 Scout