


Section 25 Township 23 Range 4-W

Well Number #7 Roberts

Company Olson & Shell

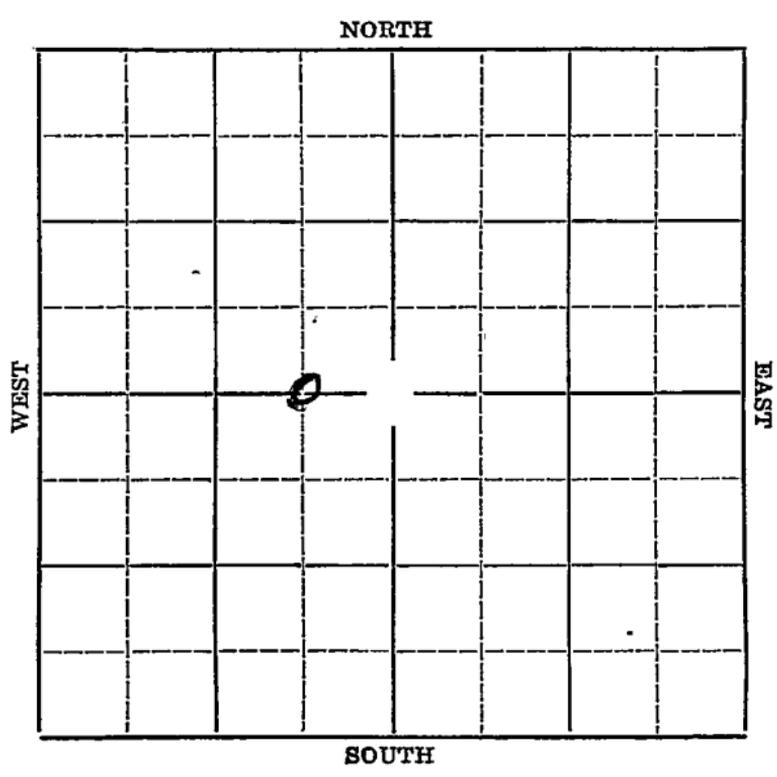

KANSAS

Map No. 40 Sec. 25 Twp. 23 R. 4W

Well No. 7 R. Lee Co.

Dixon & Shell Company

Contractor

SECTION PLAT

2640 Ft. from N. Line

_____ Ft. from S. Line

660 Ft. from E. Line

_____ Ft. from W. Line

REPORT

Location ✓

Rig up _____

Drilling and Remarks:

RECORD

Cased _____ in., _____ ft.

Sand _____

Gas _____

Oil _____

Total Depth _____

PRODUCTION

1st 24 hrs. Nat. _____

1st 24 hrs. after shot _____

Gas _____ Cu. Ft.

Dry Hole _____

Abandoned _____

Date

NOV 4 1936

19

S. J. LEWIS

Scout

KANSAS


Map No. 40 Sec. 25 Twp. 23 R. 4W.

Well No. 7 Roberts

Olson & Speltz Company

Contractor

SECTION PLAT

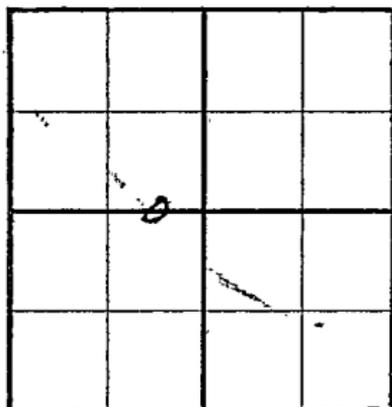

2640 Ft. from N. Line

_____ Ft. from S. Line

660 Ft. from E. Line

_____ Ft. from W. Line

COMPLETED

RECORD

Location _____

Cased _____ in., _____ ft.

Rig up _____

Sand _____

Drilling and Remarks:

Gas _____

Chas 73257

Oil _____

Total Depth 3374

1000 acid

PRODUCTION

PT 264

1st 24 hrs. Nat. _____

1st 24 hrs. after shot _____

Gas _____ Cu. Ft.

Dry Hole _____

Abandoned _____

Date

DEC 9 1936

19

S. J. LEWIS

Scout