


DX 78-1

Section 25 Township 23 Range 5W

Well No. 1 Goberly

Company Pam-Kar Drlg.

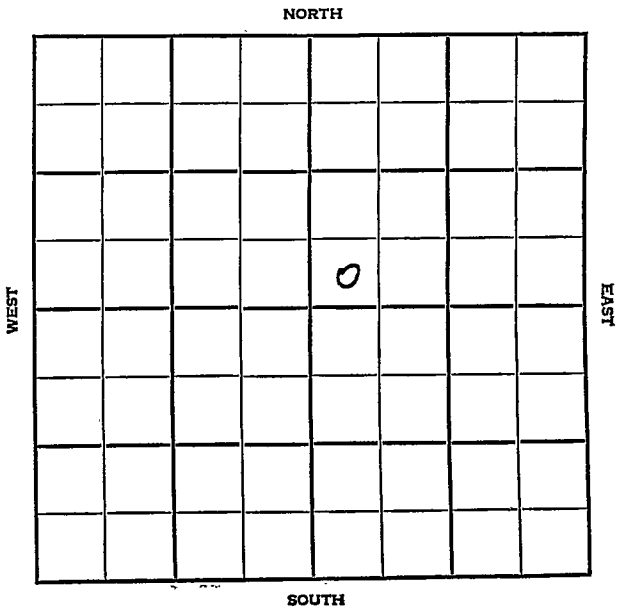

Reno

KANSAS

SEC.	TWP.	R.
25	23	5 W

WELL NO. # 1 Goberly FARM

COMPANY Pam-Kar Drlg.


CONTRACTOR Pam-Kar

Bacon Pool
Ft. from N. Line

330 Ft. from S. Line

Ft. from E. Line

330 Ft. from W. Line

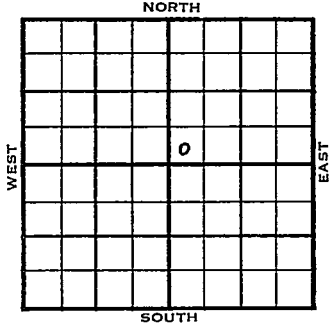

SW SW NE

	ELEVATION	REPORT
1954	1195'	
6/23	Spud 6-19-54 8" @ 200 Drlg. 1447'	
6/30	Drlg. 3516'	
7/7	Spud 6-19-54 D & A TD 3890 8" @ 200 Cong. 3366 DST 3392-3410 open 1 hr rec 4' mud off Miss 3376 Osage 3388 Kh. 3592 Meisner 3734 Maq. 3776 Simp. 3864 TD 3890 D & A	
ABANDONED		

