

# KANSAS


FORM 51 5M 10-41 PETROL

Reno

Section 25 Township 23 Range 10-W

Well No. #1 Keddie

Company Bay Petroleum etal  
Wildcat

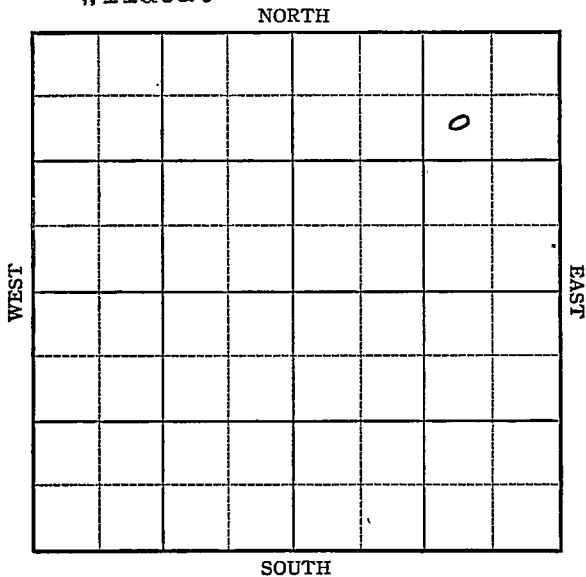

Sec. 25 Twp. 23 R. 10-W

Well No. #1 Keddie Farm

Bay Petroleum et al Company

(Wildcat)


990 Ft. from N. Line

           Ft. from S. Line

990 Ft. from E. Line

           Ft. from W. Line

Elev. 1753

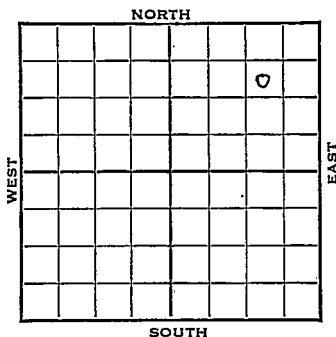

1942

REPORT

8/27 Drlg. 250'

9/2 8" - 256

Anhy 1338

Drlg. 2300

9/9 Topeka 2764 Lans 3268

Drlg. 3511

9/16 BKC 3547 Miss 3659

Viola 3816 Drlg 3880

9/23 Arb. 3985

TD 4010

No shows

**ABANDONED**

Reno

KANSAS

Map No. 47 Sec. 25 Twp. 23 R. 10 WWell No. 1 KeddieBay Petroleum etal. Company**FIRST REPORT**

Contractor

SW NE NE

990 Ft. from N. Line

\_\_\_\_\_ Ft. from S. Line

990 Ft. from E. Line

\_\_\_\_\_ Ft. from W. Line

## SECTION PLAT


WILDGAT

## RECORD

Location \_\_\_\_\_

Cased \_\_\_\_\_ in., \_\_\_\_\_ ft.

Rig up \_\_\_\_\_

Sand \_\_\_\_\_

Drilling and Remarks:

Gas \_\_\_\_\_

Oil \_\_\_\_\_

Total Depth \_\_\_\_\_

Drlg. 250'

## PRODUCTION

1st 24 hrs. Nat. \_\_\_\_\_

1st 24 hrs. after shot \_\_\_\_\_

Gas \_\_\_\_\_ Cu. Ft.

Dry Hole \_\_\_\_\_

Abandoned \_\_\_\_\_

Date

AUG 27 1942 19

S. J. LEWIS Scout

KANSAS  
 Map No. 47 Sec. 25 Twp. 23 R. 10W

Well No. 1 Keddie

Bay Petroleum et al. Company

ABANDONED Contractor

SW NE NE

SECTION PLAT

990 Ft. from N. Line

\_\_\_\_\_ Ft. from S. Line

990 Ft. from E. Line

\_\_\_\_\_ Ft. from W. Line

			o

WILDCAT

Location \_\_\_\_\_

Rig up \_\_\_\_\_

Drilling and Remarks:

*Cur 43983*

*No show*

RECORD

Cased \_\_\_\_\_ in., \_\_\_\_\_ ft.

Sand \_\_\_\_\_

Gas \_\_\_\_\_

Oil \_\_\_\_\_

Total Depth 4010

PRODUCTION

1st 24 hrs. Nat. \_\_\_\_\_

1st 24 hrs. after shot \_\_\_\_\_

Gas \_\_\_\_\_ Cu. Ft.

Dry Hole \_\_\_\_\_

Abandoned \_\_\_\_\_

Date

SEP 23 1942 19

S. J. LEWIS Scout