

Section 25 Township 23 Range 12-WWell No. #1 FritzmeierCompany Alpine Oil & Royalty

NORTH

0							
.							

WEST

EAST

SOUTH

KANSAS

Stafford

Sec. 25 Twp. 23 R. 12-W

Well No. #1 Fritzmeier Farm

Alpine Oil & Royalty Company

Mid-Western Contractor

Wildcat

 Ft. from N. Line


330 Ft. from S. Line

 Ft. from E. Line

330 Ft. from W. Line

SW SW NW

Mid-States DHM

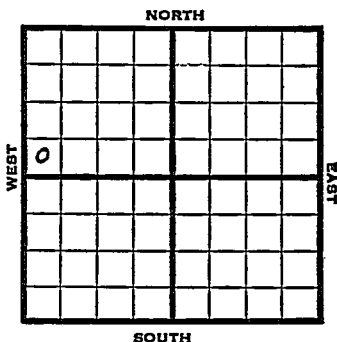

1951 Elev 1846' REPORT

1/10 Spud 1-9-51
8" @ 286'

1/24 8" @ 286

Heeb 3219

Lans 3389

SO 3475-90

DST 3475-90 opn 1 hr rec 900' gas
540' sw 900' o& wem 60% wtr

DST 3661-75 opn 1 hr rec 20' mud

Viola 3739 Simp 3810

DST 3715-70 opn 45 min rec 20' mud
Arb 3851

DST 3852-61 opn 1 hr rec 420' sw
TD 3861'

D&A

ABANDONED

Br lime 3361

3851
1846

2005

3739
1846

1893

County Stafford State Kansas
 Sec. 25 (Blk. Twp.) 23 (Sur. Rge.) 12W Map No.
 Operator Alpine Oil & Royalty
 Well No. 1 Farm Fritzmeier
 Elev. _____ Location SW SW NW

0							

FIRST REPORT

330 Ft. From S Line NW
330 Ft. From W Line Quarter
 1st. Report JAN 10 1951
 Completion _____
 Remarks Mid-States DEM
Mid-Western - Contr.
 Spudding Date 1-9-51

Drlg. Data Wildcat

8" @ 286

J. E. TYRA

County Stafford State Kansas
 Sec. 25 (Blk.) 23 (Sur.) 12W Map No.
 Operator Alpine Oil & Royalty
 Well No. 1 Farm Fritzmeier
 Elev. 1846 Location SW SW SW

0							

330 Ft. From S Line NW
330 Ft. From W Line Quarter
 Ist. Report
 Completion JAN 24 1951
 Remarks Wildcat
Mid-Western - Contr.
 Spudding Date 1-9-51

Drlg. Data D & A TD 3861
8" @ 286 Heeb. 3219 Br. lime 3361
Lans. 3389 SO 3475-90 DST 3475-90
open 1 hr. Rec. 900' gas 540' sw
900' o & wcm 60% water DST 3661-75
open 1 hr. Rec. 20' mud Viola 3739
Simp. 3810 DST 3715-70 open 45 min.
Rec. 20' mud Arb. 3851 DST 3852-61
open 1 hr. Rec. 420' sw TD 3861

D & A

J. E. TYRA