


Section 25 Township 23 Range 14W

Well No. #1 Batchman

Company Lindas Oil

NORTH

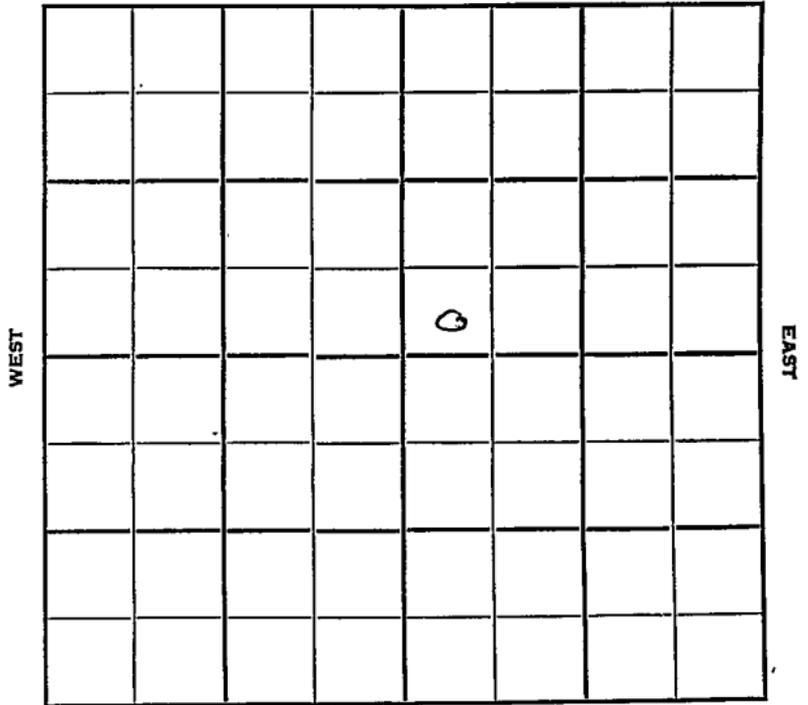

SOUTH

WEST

EAST

Stafford

KANSAS

Sec. 25 Twp. 23 R. 11W

Well No. #1 Batchman Farm

Lindas Oil Company

Contractor


Wildcat

Ft. from N. Line

330 Ft. from S. Line

Ft. from E. Line

330 Ft. from W. Line

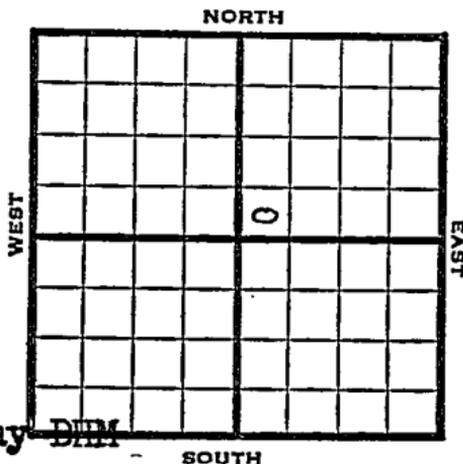

SW SW NE

Lion, Stanolind, Sunray ~~DDM~~

1952 Elev. 1942' REPORT

1/30 Spud 1-23-52
8" @ 205'
Anhy 885
Drlg. 3020'

2/6 Heeb. 3414 Bi Li 3554
Lans. 3569
DST 3584-3604 1 hr. 63' GCM
DST 3691-3704 1 hr 29' SOCM
1130# bhp
DST 3723-40, 1/2 hr. 10' mud 1180#
BKC 3798 Cong. 3838
Viola 3946 Drlg. 4070'

2/12 Spud 1-23-52
D&A TD 4075
8" @ 205 Anhy 885 Heeb. 3414
Br lime 3554 Lans. 3569
DST 3584-3604 opn 1 hr.
Rec. 63' gcm DST 3691-3704 opn
1 hr Rec. 29' socm
DST 3723-40 opn 1/2 hr Rec. 10' mud
BKC 3798 Cong. 3838 Viola 3946
DST 3956-85 opn 45 min.
Rec. 30' mud Simp 4001
Arb. 4062 DST 4065-75 opn 20 min.
Rec. 450' socsw
D&A **ABANDONED**


County Stafford State Kansas

Sec. 25 (Bk. Twp.) 23 (Sur. Rge.) 14W Map No.

Operator Lindas Oil

Well No. 1 Farm Batchman

Elev. 1942 Location SW SW NE

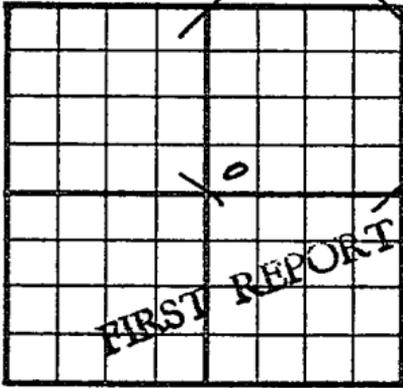

330 Ft. From S Line NE

330 Ft. From IV Line Quarter

Ist. Report JAN 30 1952

Completion

Remarks Lion, Stanelind,

Sunray - DHM

Spudding Date 1-23-52

Drlg. Data Wildcat

8" @ 205 Anhy 885 Drlg. 3020

J. G. MCGEHEE


County Stafford State Kansas

Sec. 25 (^{Blk.}23 ^{Twp.}) (^{Sur.}14W ^{Rge.}) Map No.

Operator Lindas Oil

Well No. 1 Farm Batchman

Elev. 1942 Location SW SW NE

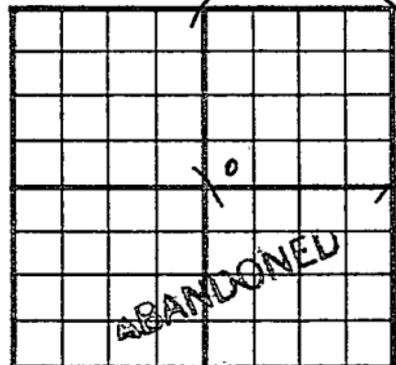

330 Ft. From S Line NE

330 Ft. From W Line Quarter

1st. Report

Completion FEB 13 1952

Remarks Wildcat

Spudding Date 1-23-52

Drlg. Data D & A TD 4075

8" @ 205 Anhy 885 Heeb. 3414

Br. lime 3554 Lans. 3569 DST 3584-3604

open 1 hr. Rec. 63' gcm DST 3691-3704

open 1 hr. Rec. 29' socm DST 3723-40

open $\frac{1}{2}$ hr. Rec. 10' mud B KC 3798

Cong. 3838 Viola 3946 DST 3956-85

open 45 min. Rec. 30' mud Simp. 4001

Arb. 4062 DST 4065-75 open 20 min.

Rec. 450' socsw

D & A