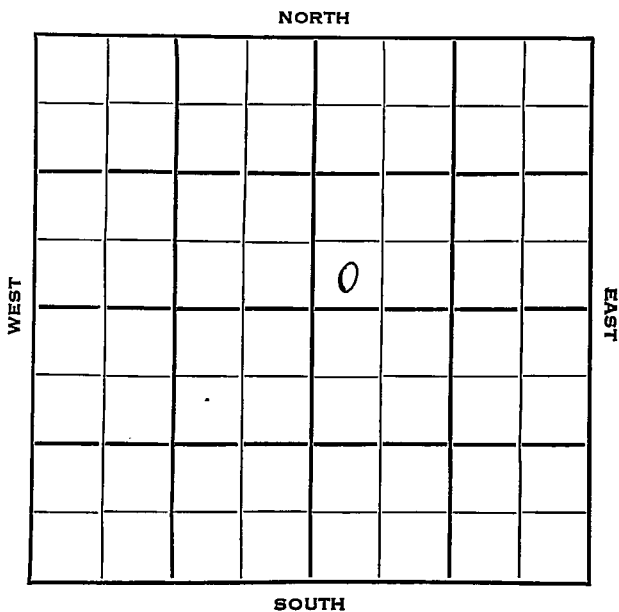


Section 25 Township 23 Range 15 WWell No. # 1 HohnerCompany Greenland Drlg.

Pawnee

KANSAS

SEC.	TWP.	R.
25	23	15 W

WELL NO.

1 Hohner

FARM

COMPANY

Greenland Drlg.

CONTRACTOR

Greenland

Wildcat


_____ Ft. from N. Line

330 _____ Ft. from S. Line

_____ Ft. from E. Line

330 _____ Ft. from W. Line

SW SW NE

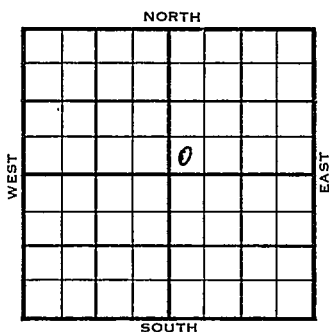

	ELEVATION	REPORT
1953	1991'	

12/30 Spud 12-28-53
8" @ 208 WOC

1954
1/6 Heeb 3491', Br. L. 3627', Lans 3638'
Drlg 3695'

1/13 Spud 12-28-53 D & A TD 4138'
8" @ 208 Heeb 3491 Br lime 3627'
Lans. 3638' Cong. 3995' Viola 4035'
Simp. 4062' Arb. 4111'
TD 4138' D & A

ABANDONED

J. G. McGEHEE


County Pawnee State Kansas

Sec. 25 (Blk. Twp.) 23 (Sur. Rge.) 15W Map No. _____

Operator Greenland Drlg.

Well No. 1 Farm Hohner

Elev. 1994 Location SW SWNE

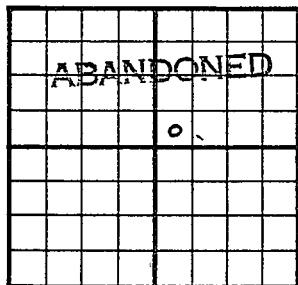

330 Ft. From S Line NE

330 Ft. From W Line Quarter

Ist. Report

Completion JAN 13 1954

Remarks Wildcat

Greenland - Contr.

Spudding Date 12-28-53

Drlg. Data D & A TD 4138

8" @ 208 Heeb. 3491 Br. lime 3627

Lans. 3638 Cong. 3995 Viola 4035

Simp. 4062 Arb. 4111 TD 4138

D & A

J. G. McGEHEE