


Section 25 Township 23 Range 17W
Well No. 1 Carpenter "A"
Company C. U. Bay

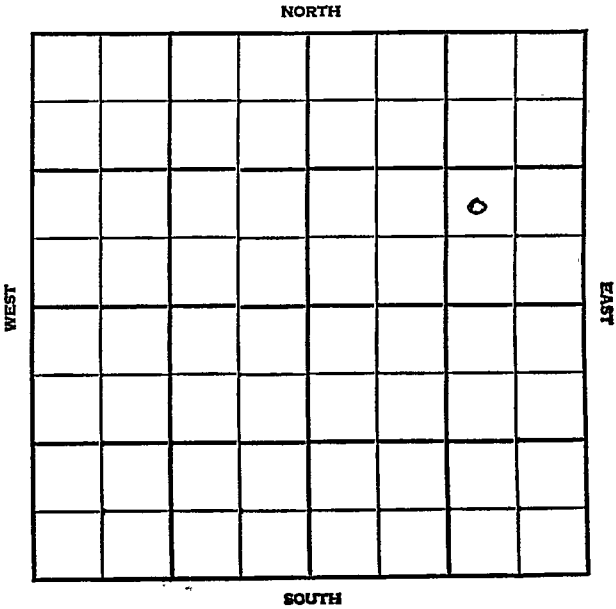

Pawnee KANSAS

SEC.	TWP.	R.
25	23	17 W

WELL NO.

1 Carpenter "A"

COMPANY FARM

G. U. Bay

CONTRACTOR

Jackson Drlg.
Wildcat


_____ Ft. from N. Line

990 _____ Ft. from S. Line

1065 _____ Ft. from E. Line

_____ Ft. from W. Line

NW SE NE

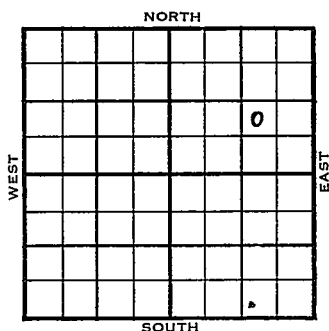

	ELEVATION	REPORT
1954	2075'	.
12/22	Spud 12-15-54 8" @ 210 Drlg. 3150'	
4/6	Spud 12-15-54, oil well TD 4320 8" @ 210, Heeb 3636, Br Lim 3757, Lans 3763, BKG 4123, Cherokee 4184, Cong 4190, Miss 4223, Viola 4301, TD 4320, 5" @ 4319, CO to 4241, 32/4230- 38, 8 GWPH sd-oil-frac 300 BW 12 hr. sq perf CO to 4230 32/ 4 208, -16, frac, S/1 3/4 BOPH 2 hr. S/1 1/2 BOPH 18 hr. P/ 29 BO 20 hr. dec to 8 BOPD CO to 4245, 24/4234-40, frac S/2 BOPH 50% wtr. Dec to 1 BOPH 50% wtr. SP 4200 16/4185-8 89 gas in 30 min. 12 go 1 hr frac SP 4178 40/4158-68 500A S/22 BO 4 1/2 hr S/1 3/4 BOPH S/1 boph 1500 A s/40 BO 12 hr. S/28 BO 12 hr Comp 7 BOPD	
COMPLETED		

County Pawnee State Kansas
 Sec. 25 (Blk. Twp.) 23 (Sur. Rge.) 17W Map No. note
 Operator C. U. Bay
 Well No. 1 Farm Carpenter "A"
 Elev. _____ Location NW SE NE

FIRST REPORT

990 Ft. From S Line NE
1065 Ft. From N Line Quarter
 1st. Report DEC 22 1954

Completion _____

Remarks _____

Jackson Drlg. - Contr.


Spudding Date 12-15-54

Drlg. Data Wildcat

8" @ 210 drlg. 3150

FABEN GILSTRAP

County Pawnee State Kansas
 Sec. 25 (Bk. Twp.) 23 (Sur. Rge.) 17W Map No. _____
 Operator C. U. Bay
 Well No. 1 Farm Carpenter "A"
 Elev. 2075 Location NW SE NE

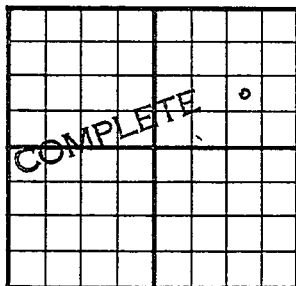

990 Ft. From S Line NE
1065 Ft. From E Line Quarter

1st. Report

Completion APR 6 1955

Remarks Carpenter Pool
Jackson Drlg. - Contr.

Spudding Date 12-15-54

Drlg. Data Oil well TD 4320

8" @ 210 Heeh. 3636 Br. lime 3757

Lans. 3763 B KC 4123 Cherokee 4184

Cong. 4190 Miss. 4223 Viola 4301

TD 4320 5" @ 4319 CO to 4241 32/ 4230-

38 8 gwph sd-oil-frac 300 bw 12 hr.

sq perf. CO to 4230 32/ 4208-16

frac S/ 1 3/4 boph 2 hr. S/ 1 1/2 boph

18 hr. P/ 29 bo 20 hr. dec. to 8 bopd

CO to 4245 24/ 4234-40 frac S/ 2 boph

50% wtr. dec. to 1 boph 50% wtr.

SP 4200 16/ 4185-89 gas in 30 min.

12 go 1 hr. frac SP 4178 40/ 4158-68

500 A S/ 22 bo 4 1/2 hr. S/ 1 3/4 boph

S/ 1 boph 1500 A S/ 40 bo 12 hr.

FABEN GILSTRAP

Drig. Data

S/ 28 bo 12 hr. Comp. 7 bopd

APR 14 1955

Scout Cards	mm
Land Small Map	
Land Wall Map	
Tracings	
France Map	
Pierce Map	
Misc.	