


DX 78-1 Pawnee

KANSAS

Section 25 Township 23S Range 17W

Well No. #2 Keller "C"

Company GRA & Rex & Morris

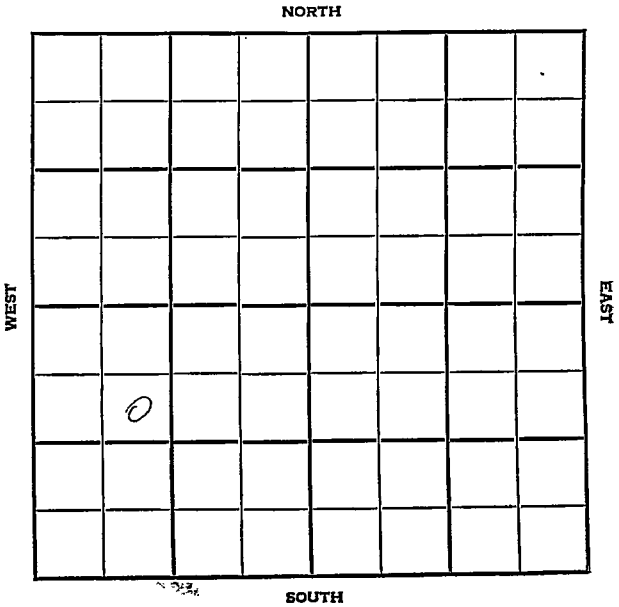

Pawnee

SEC. 25	TWP. 23	KANSAS ### 17W
WELL NO. #2 Keller "C"		
FARM		
COMPANY CRA & Rex & Morris		
CONTRACTOR		

_____ FT. FROM N. LINE	WEST	NORTH	EAST
_____ FT. FROM S. LINE			
_____ FT. FROM E. LINE			
_____ FT. FROM W. LINE			
SE NW SW		SOUTH	

1956	ELEVATION	REPORT
	2078'	
8-1	MIR	
8-29	Comm. 8-6-56 8 5/8" @ 310 w/250 Lost surf. pipe; Skid rig 20' NW; Re-Spud 8-13-56 8 5/8" @ 250 w/200 DST 4172-4211 op 1 hr., rec. 20' mud, BHP 0/20". DST 4216-55 op 30 min. failed DST 4216-55 op 30 min. rec. 15' mud, DST 4242-87 op 30 min. rec. 35' mud, BHP 600/20" # D & A H. 3642'; Tr. 3667'; Dg. 3680'; BL. 3762'; L. 3773'; BKC 4048'; Ft. Sect. 4150'; Log tops: H. 3642'; BL. 3762'; L. 3770'; BKC 4045'; Ft. Sect. 4145'; C. 4180'; V. 4285' TD 4325'	
		ABANDONED

Date Comm. AUG 1 1956

MIR

SECRET

County PawneeElev. 2078Sec. 25Twp. 23SRge. 17WCompany CRA & Rex & MorrisFarmName Keller "C"No. 2

TOPS	DEPTH	LOG	DATUM	Loc. in Sec.
Anh.				SE NW SW
Tr.				
H.	3642	3642		
Tr.	3667			
Dg.	3680			
Bl.	3762	3762		
L.	3773	3770		
K.C.				Geol.
B.K.C.	4048	4045		Contr.
Ce.	4150	4145		
C.		4180		
M.				Pool
M.				
K.				
Mz.				
Mo.				
V.		4285		
S.				
S.				
A.				
R.				
Pe.				
G.				
TD.	4325	2770		

ABANDONED

Date Comm. AUG 29 1956IIR AUG 8 '568-6-56 8583101250AUG 15 '56Lost surf lineskid Rig 20' NW Re spd8-13-56 858 250/200AUG 22 '564050AUG 29 '56DST 4172-42111hr. run 20' Md BHP 0/20DST 4216-55 30" FailedDST 4216-55 30" 15' Md nopress recorded DST 4242-87

30" rec 35' Md BHP 600 / 20

D&A

25-23.17 DE. M. J. 115