


Section 25 Township 23 Range 17W

Well No. #1 Keller

Company Barnett Oil

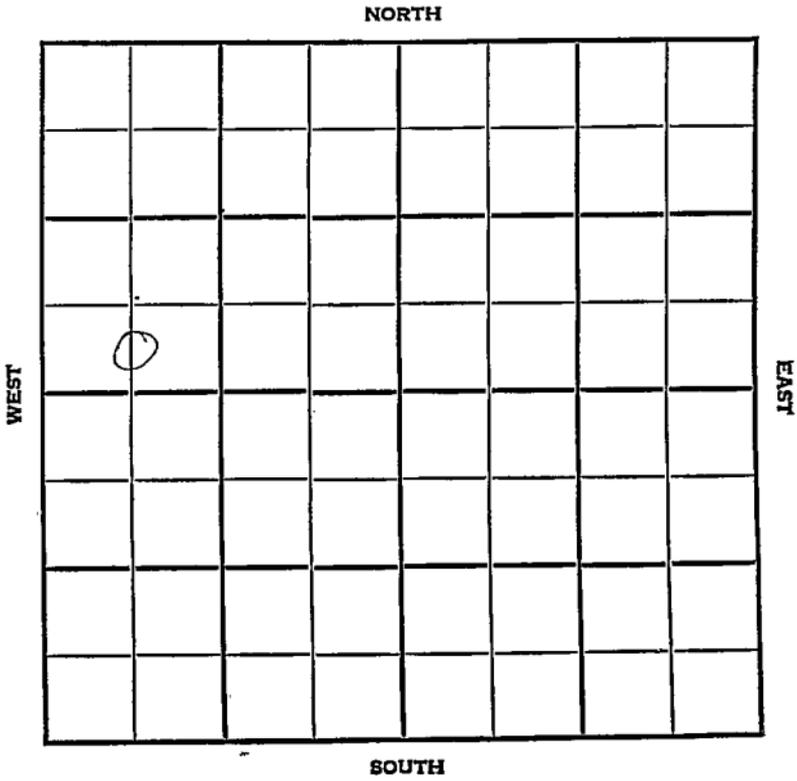

County Paynee Elev. _____
 Sec. 25 Twp. 23 Rgs. 17W
 Company Barnett Oil
 FarmName Keller No. 1

TOPS	DEPTH	LOG	DATUM
Anh.			
Tp.			
H.			
Tr.			
Dg.			
Bl.			
L.			
K.C.			
B.K.C.			
Ce.			
C.			
M.			
M.			
K.			
Mz.			
Me.			
V.			
S.			
S.			
A.			
R.			
PE.			
G.			
T.D.			

Loc. in Sec. C S $\frac{1}{2}$ SW NW
 Geol. _____
 Contr. _____
Co. tools
 Pool _____
W. Carpenter

FIRST REPORT
 NOV 14 '56

Date Comm. 11-8-56
8" @ 192/175 WOC

[Handwritten signature]

6661 G S VON

[Handwritten marks]

Co.
Lse.
No.
Sec.
T.
R.

5.88 Bo # 3 hrs \$ 5.04

Bo no/w 3 hrs \$ 1.30

Bo T E R DEC 12 '56 DEC 14 '56 wopst

DEC 1 '56 DEC 26 '56 JAN 2 '57 P. 40

Bopd + est 2 Bw in 24 hrs

JAN 2 '57 Ph P. 183 Bopd no/w

quar 38°