


Finney

KANSAS

SECTION 25 TOWNSHIP 23 RANGE 32^W

WELL NO. #1 Baker G.U.

COMPANY Petroleum Inc.

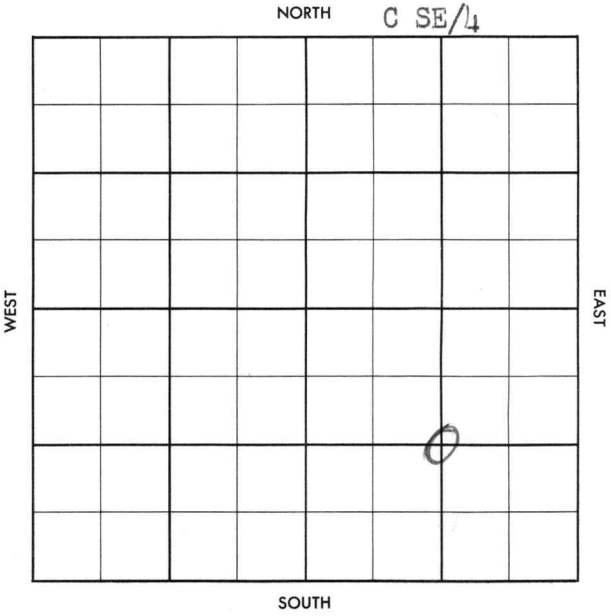

County Finney Elev. _____
 Sec. 25 Twp. 23 Rge. 32W
 Company Petroleum Inc.
 Farm Name Baker G. U. No. 1

TOPS	DEPTH	LOG	DATUM	Loc. in Sec.
Anh.				C SE/4
Tp.				
H.				
Tr.				
Dg.				
Bl.				
L.				Geol.
K.C.				Contr.
B.K.C.				Co. Tools
Ce.				Pool
C.				Hugoton
M.				
M.				
K.				
Mz.				
Mq.				
V.				
S.				
S.				
A.				
R.				
Pe.				
G.				
T.D.				

FIRST REPORT

JUN 26 57

Date Comm.

RURT

3.5

Co.

Lse.

No.

Sec.

T.

R.

County Finney Elev. 2924 DF Co. 25 Twp. 23 Rge. 32W
 Company Petroleum Inc.
 Farm Name Baker G. U. No. 1

TOPS	DEPTH	LOG	DATUM	Loc. in Sec.
Anb. <u>Herr</u>		<u>2670</u>		<u>C SE/4</u>
Tp. <u>KFI</u>		<u>2694</u>		
H.				
Tr.				
Dg.				
BL.				
L.				
K.C.				Geol.
B.K.C.				Contr.
Ce.				Co. Tools
C.				
M.				Pool
M.				<u>Hugoton</u>
K.				
Mz.				
Me.				
V.				
S.				
S.				
A.				
R.				
Pe.				
G.				
TD.	<u>2710</u>			

AUG 22 '57
 COMPLETE
 6

Date Comm.

RURT JUL 3 '57. 6-29-57 858328
 1200 4 1/2" C 2706 / 1050 JUL 10 '57
 MICT CO 2702 GRNL JUL 17 '57
 CO 2706 50/2674-82 Frac
 ga 2.402 MCF/L + 5.7 BSWPH 8 hrs
 ga 732 MCF/L 1/2" ch + 25 Gwph
 JUL 24 '57 JUL 31 '57 AUG 8 '57 AUG 14 '57 AUG 21 '57 72.20
 4680, CIP 436.4# PBTD 2702 DF
 2674-84