


Section 25 Township 23 Range 34W

Well No. 1 Garden City "J"

Company Cities Service

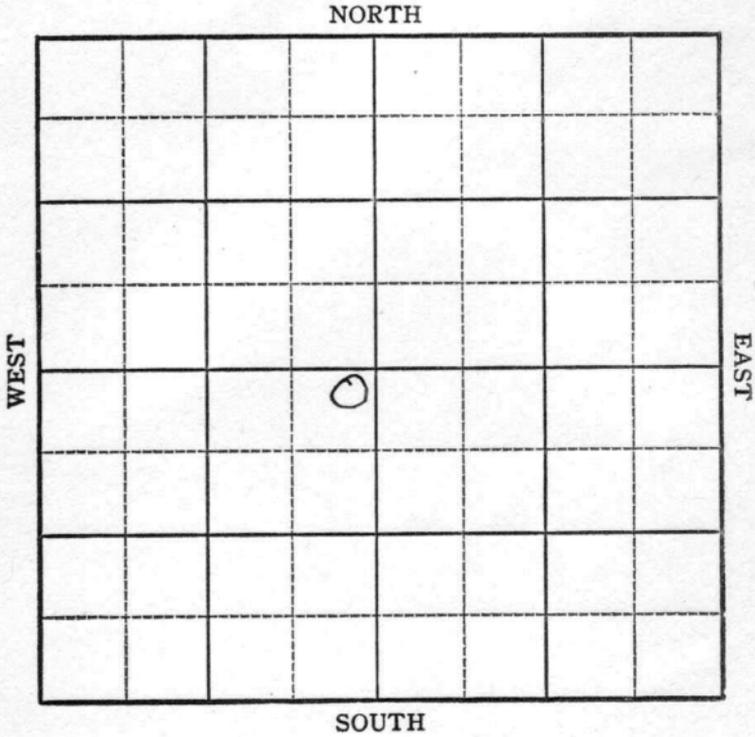

Sec. 25 Twp. 23 R. 34-W

Well No. #1 Garden City "J" Farm

Cities Service Company

Hugoton


100 Ft. from N. Line

_____ Ft. from S. Line

100 Ft. from E. Line

_____ Ft. from W. Line

NE SW

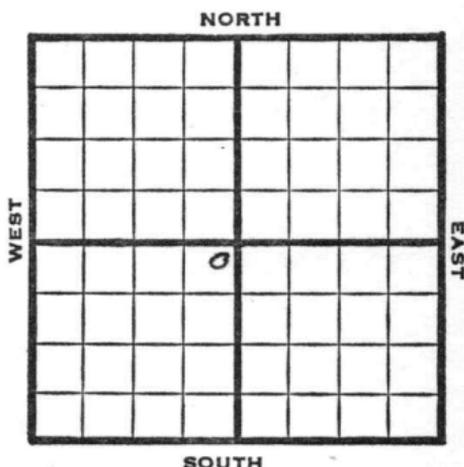

1948		REPORT
8/11	Eli 2919'	8"@ 760'
8/18	TD 2623'	5"@ 2622'
8/25	"	"
9/1	"	"
9/8	120 shots	2510-34'
	80 "	2476-82'
	40 "	2464-72'
	50 "	2428-38'
	150 "	2570-2600 - 9000 acid
9/14	"	"
9/21	"	"
9/29	TD 2623'	5"@ 2622'
	Perf 13000 acid	
	8 M Gas	
	415# R Pr	
	Comp	
COMPLETED		

Finney County Kansas State

Map No. _____ Sec. 25 Twp. 23 R. 34W

Well No. 1 Garden City "J"

Cities Service Company

FIRST REPORT

Contractor _____

NE SW

SECTION PLAT

100 Ft. from N. Line

_____ Ft. from S. Line


100 Ft. from E. Line

_____ Ft. from W. Line

Hugoton Pool

Remarks:

8" @ 760

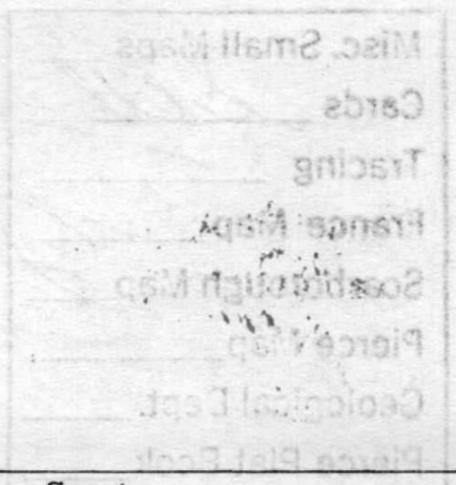

Date AUG 11 1948

Scout S. J. LEWIS

Map No. _____ Sec. 25 Twp. 23 R. 34W

Well No. 1 Garden City "J"

Cities Service Company

COMPLETE

Contractor

NE SW

E. 2912

SECTION PLAT

100 Ft. from N. Line

_____ Ft. from S. Line

100 Ft. from E. Line

_____ Ft. from W. Line

	o		

Finney County

Location _____

Rig up _____

Drilling and Remarks:

5' C2622

Per J.

13000 acid

SM Gas

415 R/R*

RECORD

Cased _____ in., _____ ft.

Sand _____

Gas _____

Oil _____

Total Depth 2622

PRODUCTION

1st 24 hrs. Nat. _____

1st 24 hrs. after shot _____

Gas _____ Cu. Ft.

Dry Hole _____

Abandoned _____

Date

SEP 29 1948

19

S. J. LEWIS

Scout