


Section 25 Township 23 Range 36 W

Well No. # 1 Damerell

Company Stanolind

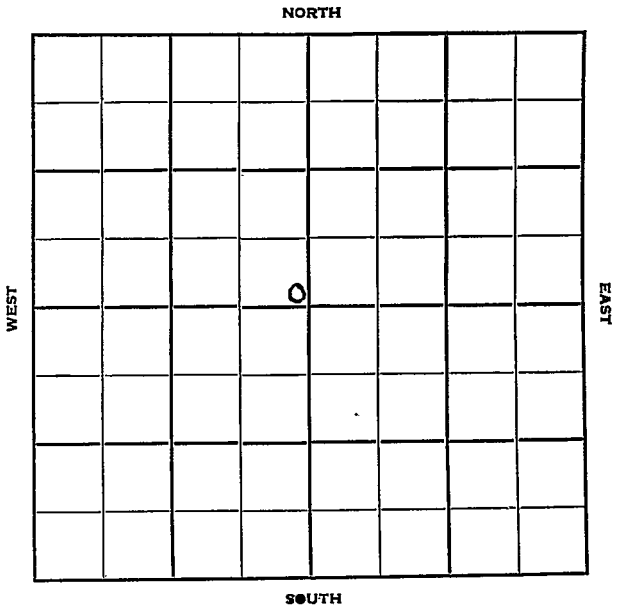

Sec. 25 Twp. 23 R. 36W

Well No. #1 Damerell Farm

Stanolind Company

Hugoton Pool Contractor


Ft. from N. Line

150' Ft. from S. Line

150' Ft. from E. Line

Ft. from W. Line

SE NW

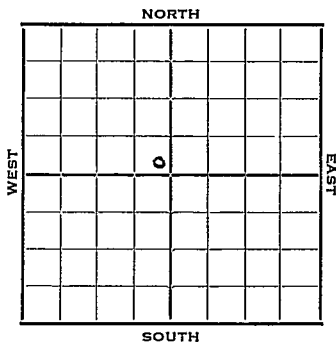

| 1952 | Elev. 3122' | REPORT |
|------------------|--------------------------------------|--------|
| 2/20 | Location | |
| 3/5 | " | |
| 3/12 | " | |
| 3/19 | " | |
| 3/25 | " | |
| 4/1 | " | |
| 4/9 | " | |
| 4/23 | MIR | |
| 4/30 | Drilling | |
| 5/7 | 8" @ 733 TD 2745 5" @ 2711 | |
| | Her 2547 Winfield 2605 | |
| | Up Ft 2659 Low Ft 2711 | |
| 5/14 | RTD 2745 CO 2500 A 18/2553-56 | |
| | 114/2560-79 60/ 2585-95 | |
| | 30/2605-10 30/2614-19 12/2625-27 | |
| | 42/2632-39 18/2659-62 102/2665-82 | |
| | 30/ 2689-92 | |
| 5/21 | 31,000 Total A 1 1/4" tub @ 2745' | |
| 5/28 | Spud 4-24-52 Gas Well TD 2745 | |
| | 8" @ 733' 5" @ 2711 TD 2745 | |
| | Her. 2547 Win. 2605 Ft. Riley 2659 | |
| | 18/ 2553-56 114/ 2560-79 60/ 2585-95 | |
| | 30/ 2605-10 30/ 2614-19 12/ 2625-27 | |
| | 42/ 2532-39 18/ 2659-62 102/ 2665-82 | |
| | 30/ 2689-92 31000 A | |
| | Comp. 7,775,000 gas | |
| COMPLETED | | |

