


Section 25 Township 23 Range 38W

Well No. 1 Wilson

Company W. E. Bakke

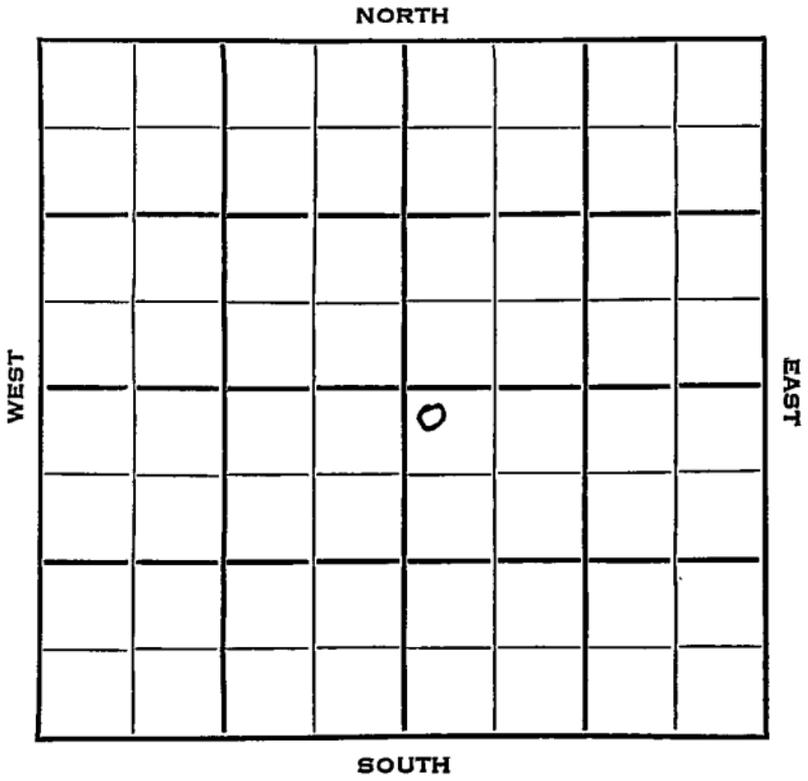

Kearny

KANSAS

SEC. 25	TWP. 23	R. 38W
------------	------------	-----------

WELL NO. #1 Wilson FARM

COMPANY W.E. Bakke

CONTRACTOR

Hugoton Pool


150 Ft. from N. Line

Ft. from S. Line

Ft. from E. Line

150 Ft. from W. Line

NW NW SE

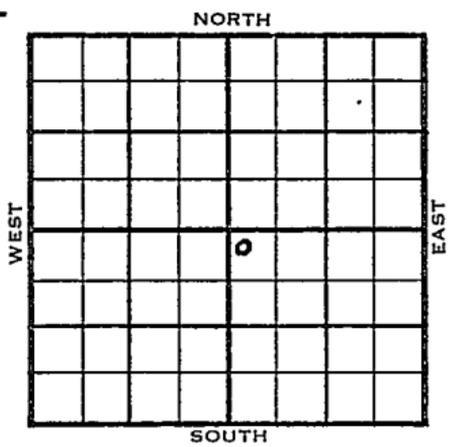

	ELEVATION	REPORT
1953	3331'	

11/4 Spud 10-29-53
8" @ 332'
WOC

11/11 RTD 2612'
5" @ 2601' w/200 sks
MICT

11/18 DD 2620
Her. 2603'

12/2 Spud 10-29-53 Gas well TD 2800'
8" @ 332 Her. 2603'
Win. 2768' TD 2612 5" @ 2601
DD 2620 DD 2800 PB 2705 frac.
4,318,000 gas PD Comp.

COMPLETED

County Kearny State KansasSec. 25 (Blk. Twp.) 23 (Sur. Rge.) 38W Map No.Operator W. E. BakkeWell No. 1 Farm WilsonElev. Location NW NW SE

FIRST REPORT					
			o		

150 Ft. From N Line SE150 Ft. From W Line Quarter1st. Report NOV 4 1953

Completion _____

Remarks _____

Spudding Date 10-29-53Drilg. Data Hugoton Pool8" @ 332 WOC

