


Map No. KANSAS Sec. 26 Twp. 23 R. 4th

Well No. 1-Base Farm Linclair Prairie Company

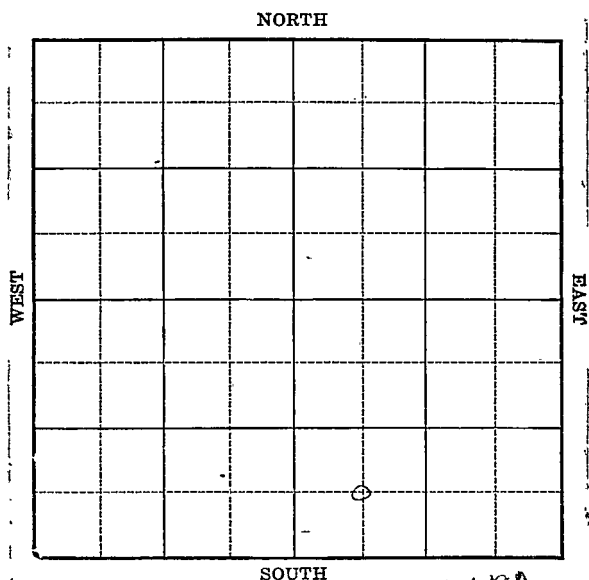

Location _____

Drilling Remarks _____

RECORD

Cased _____ in. _____ ft.

Sand _____

Gas _____

Oil _____

Total Depth _____

Rig Up _____

Drilling Remarks _____

PRODUCTION

1st 24 hrs. Nat. _____

1st 24 hrs. after shot _____

Gas _____ cu. ft.

Dry Hole _____

Abandoned _____

Map No. KANSAS Sec. 26 Twp 23 R. 4th
Well No. 1-Base Farm
Cinclair - Prairie Company


 Ft. from N. Line

660 Ft. from S. Line

 Ft. from E. Line

660 Ft. from W. Line

1933

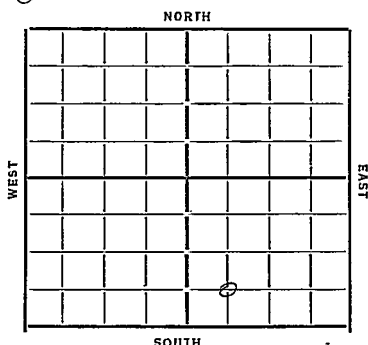

Date

REPORT

2/15	Cellar
2/22	Drdg
3/14	15" - 257 12" 479' dly 735
3/18	Drly 2782'
3/15	Top Chat 3230 Cement 8" 3237'
3/22	J.D. 3320' Cat 23M gas & spray oil
3/29	No test
4/4	—
4/12	8" 3238 Chat 3230-3320' J.H., Cat 25 to 30 bbls oil per day 22M gas Completed
1934	OWDD
1/10	Drilling deeper
3/28	Hutton 3585 T.D. 3591 903 bbls oil 20 hrs
	COMPLETED
	COMPLETED

40 KANSAS

Map No. Sec. 26 Twp. 23 R. 4

Well No. 1 Base

Dinclair Prairie Company

Contractor

FIRST REPORTS

Ft. from N. Line

660 Ft. from S. Line

Ft. from E. Line

660 Ft. from W. Line

SECTION PLAT

Location

Rig up

Drilling and Remarks:

Clear

RECORD

Cased in., ft.

Sand

Gas

Oil

Total Depth

PRODUCTION

1st 24 hrs. Nat.

1st 24 hrs. after shot

Gas Cu. Ft.

Dry Hole

Abandoned

Date

FEB 15 1933 CHAS. L. SHERWOOD

192

Scout

40 KANSAS Reno
 Map No. Sec. 26 Twp. 23 R. 4 W

Well No. 1 Base

Linclair - Prairie Company

Contractor

COMPLETED

Ft. from N. Line

660 Ft. from S. Line

Ft. from E. Line

660 Ft. from W. Line

SECTION PLAT

		0	

Location

Rig up

Drilling and Remarks:

EM 25 to 30
 Bld Oil Per Day

RECORD

Cased 8 in., 3238 ft.

Sand Chert 3230-3320

Gas

Oil

Total Depth 3320

PRODUCTION

1st 24 hrs. Nat.

1st 24 hrs. after shot

Gas 22 M Cu. Ft.

Dry Hole

Abandoned

Date

APR 12 1933

192

CHAS. L. SHERWOOD

Scout

Map No. 40 Sec. 26 Twp. 23 R. 4WWell No. 1-BaseSinclair - prairie Company

Contractor

FIRST REPORTS**SECTION PLAT**

		0	

Ft. from N. Line

660 Ft. from S. Line

Ft. from E. Line

660 Ft. from W. LineQWP N**RECORD**

Location

Cased.....in.,ft.

Rig up

Sand.....

Drilling and Remarks:

Gas.....

Oil.....

Total Depth.....

PRODUCTION

1st 24 hrs. Nat.....

1st 24 hrs. after shot.....

Gas.....Cu. Ft.

Dry Hole.....

Abandoned.....

Date

1-10-34 192 C. W. Wamschrodt Scout

Map No. 48 Sec. 26 Twp. 23 R. 4W

Well No. 1 Base

Sinclair - prairie Company

~~CONTRACTED~~ Contractor

SECTION PLAT

660 Ft. from N. Line

660 Ft. from S. Line

660 Ft. from E. Line

660 Ft. from W. Line

		0	

Location.....

Rig up.....

Drilling and Remarks:

90 3 lbs
20 hrs.

RECORD

Cased.....in.,.....ft.

Sand Hunter 3585

Gas.....

Oil.....

Total Depth 3591

PRODUCTION

1st 24 hrs. Nat.....

1st 24 hrs. after shot.....

Gas.....Cu. Ft.

Dry Hole.....

Abandoned.....

Date

3/28/34 192 O. Marmelback Scout