


Reno

KANSAS

Section 26 Township 23 Range 4-W

Well Number 9 Goering

Company Olson Drlg.

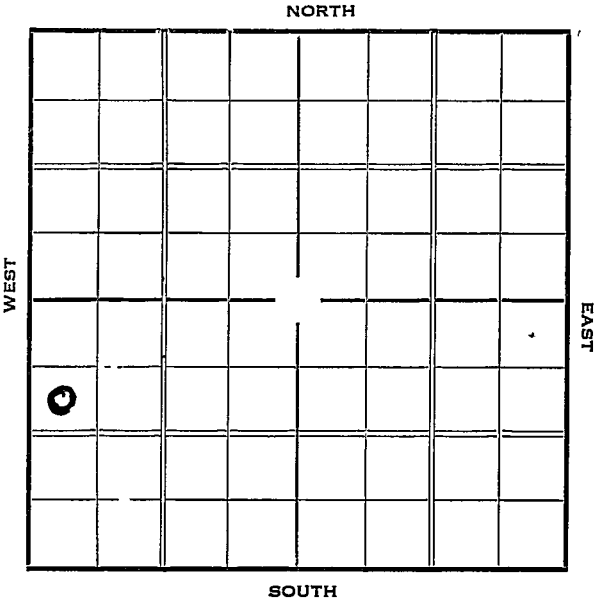

1937

7/28

5" @ 3581' ?

Hunton 3581'

TD 3584'

Pot 1368'

Nat.

COMPLETED

KANSAS*Penn*

Map No.

40

Sec.

26

Twp.

23

R.

4N

Well No.

*9**Goering*

Company

Contractor

SECTION PLAT

0			

990 Ft. from N. Line

_____ Ft. from S. Line

_____ Ft. from E. Line

230 Ft. from W. Line**FIRST REPORT**

Location

**RECORD**

Cased _____ in., _____ ft.

Sand _____

Gas _____

Oil _____

Total Depth _____

PRODUCTION

1st 24 hrs. Nat. _____

1st 24 hrs. after shot _____

Gas _____ Cu. Ft.

Dry Hole _____

Abandoned _____

Date

APR 14 1937₁₉

S. J. LEWIS

Scout

Reno KANSAS

Map No. 40 Sec. 26 Twp. 23 R. 4WWell No. 9-GoeringOlson Drilling Company

Contractor

COMPLETED

SECTION PLAT

990 Ft. from N. Line

_____ Ft. from S. Line

_____ Ft. from E. Line

330 Ft. from W. Line

Location _____

Rig up _____

Drilling and Remarks:

Pat-1368NAT

RECORD

Cased 5" in., 3581 ft.?Sand Hunter 3581

Gas _____

Oil _____

Total Depth 3584

PRODUCTION

1st 24 hrs. Nat. _____

1st 24 hrs. after shot _____

Gas _____ Cu. Ft.

Dry Hole _____

Abandoned _____

Date

H. D. Hatfield

JUL 28 1937

Scout