



*Keno*

Map No. KANSAS Sec. 26 Twp. 23 R. 4W


Well No. 5-A Goring Farm  
Olsen & Shell Company

330 Ft. from N. Line

\_\_\_\_\_ Ft. from S. Line

330 Ft. from E. Line

\_\_\_\_\_ Ft. from W. Line

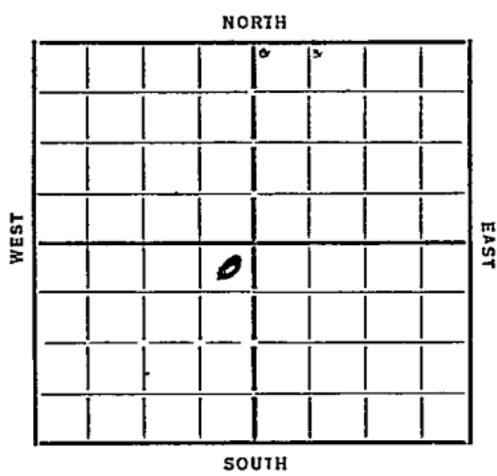

Date	REPORT	O. W. D. D
<i>1935</i>		
<i>3/20</i>	<i>Rgn Rot.</i>	
<i>3/28</i>	<i>alg 953</i>	<i>12 1/2 480</i>
<i>4/4</i>	<i>" 2415</i>	
<i>4/11</i>	<i>" 3255</i>	<i>Chat 3270 3229</i>
<i>4/18</i>	<i>Chat Cor 3229</i>	
	<i>8 1/4 3564 Rust</i>	
<i>4/26</i>	<i>Hutton 3569 T7 3584 14 F.O.</i>	
<i>5/1</i>	<i>Hutton 3569 T7 3584</i>	
	<i>2000 acid 1979 Bbls.</i>	

COMPLETED

1939	O. W. D. D
<i>5/17</i>	<i>Viola 3685' Simpson 3703'</i>
	<i>Arb. 3786' T.D. 4251'</i>
	<i>5" - 3830' WOC.</i>
<i>5/26</i>	<i>5" - 3890'</i>
<i>6/1</i>	<i>Drig. 4468' in Arb.</i>
<i>6/8</i>	<i>Granite 4495</i>
	<i>T.D. 4497'</i>
<i>6/16</i>	<i>" "</i>

OVER

1939

6/27

Granite 4495'

T.D. 4497'

Input 300 bbls. per hour.

SALT WATER DISPOSAL.

ABANDONED

Map No. 40 Sec. 26 Twp. 23 R. 4W

Well No. 5A-Boering

Olsen & Shell Company

Contractor

FIRST REPORTS

SECTION PLAT

330 Ft. from N. Line

..... Ft. from S. Line

330 Ft. from E. Line

..... Ft. from W. Line

		o	

Location.....

Rig up.....

Drilling and Remarks:

*Rig in Kat*

RECORD

Cased..... in., ..... ft.

Sand.....

Gas.....

Oil.....

Total Depth.....

PRODUCTION

1st 24 hrs. Nat.....

1st 24 hrs. after shot.....

Gas..... Cu. Ft.

Dry Hole.....

Abandoned.....

Date

3-20-35 192.....

*ORVAL H. JACOBS*

Scout

Map No. 40 Sec. 26 Twp. 23 R. 4W

Well No. 5A-Gearing

Olson + Shell Company

Contractor

**COMPLETED**

SECTION PLAT

	0		

330 Ft. from N. Line

..... Ft. from S. Line

330 Ft. from E. Line

..... Ft. from W. Line

Location.....

Rig up.....

Drilling and Remarks:

2000 and

1979

RECORD

Cased..... in., ..... ft.

Sand Hunter 3569

Gas.....

Oil.....

Total Depth 3584

PRODUCTION

1st 24 hrs. Nat.....

1st 24 hrs. after shot.....

Gas..... Cu. Ft.

Dry Hole.....

Abandoned.....

Date

5-5-35 192.....

**ORVAL MANN SCHREY**

Scout

Map No. 40 Sec. 26 Twp. 23 R. 4WWell No. 5 GoeringOlson & Shell Company

Contractor

## FIRST REPORT

NE SW

## SECTION PLAT

330 Ft. from N. Line

\_\_\_\_\_ Ft. from S. Line

330 Ft. from E. Line

\_\_\_\_\_ Ft. from W. Line

		O	

## BURRTON-HAURY POOL

Location \_\_\_\_\_

Rig up \_\_\_\_\_

Drilling and Remarks:  
OWDD-OTD 3597Viola 3685Simpson 3703Arb. 3786T.D. 42515" @ 3830 WOC

## RECORD

Cased \_\_\_\_\_ in., \_\_\_\_\_ ft.

Sand \_\_\_\_\_

Gas \_\_\_\_\_

Oil \_\_\_\_\_

Total Depth \_\_\_\_\_

## PRODUCTION

1st 24 hrs. Nat. \_\_\_\_\_

1st 24 hrs. after shot \_\_\_\_\_

Gas \_\_\_\_\_ Cu. Ft.

Dry Hole \_\_\_\_\_

Abandoned \_\_\_\_\_

Date

MAY 17 1939 <sub>19</sub>S. J. LEWIS  
Scout

Map No. 40 Sec. 26 Twp. 23 R. 4W

Well No. 5 Goering

Olson & Shell Company

Contractor

COMPLETED

SECTION PLAT

NE SW

330 Ft. from N. Line

\_\_\_\_\_ Ft. from S. Line

330 Ft. from E. Line

\_\_\_\_\_ Ft. from W. Line

	0		

BURRTON HAURY POOL

Location \_\_\_\_\_

Rig up \_\_\_\_\_

Drilling and Remarks:

*Granite 4495*

*Input 30086*

*per hr*

*S. W. Dignel*

RECORD

Cased \_\_\_\_\_ in., \_\_\_\_\_ ft.

Sand \_\_\_\_\_

Gas \_\_\_\_\_

Oil \_\_\_\_\_

Total Depth 4497.

PRODUCTION

1st 24 hrs. Nat. \_\_\_\_\_

1st 24 hrs. after shot \_\_\_\_\_

Gas \_\_\_\_\_ Cu. Ft.

Dry Hole \_\_\_\_\_

Abandoned \_\_\_\_\_

Date

JUN 21 1939 19

S. J LEWIS Scout