


Map No. KANSAS Sec. 26 Twp. 23 R. 4W
 Well No. 1-B # E. Krehbiel Farm
Olsen & Shell Company

NORTH

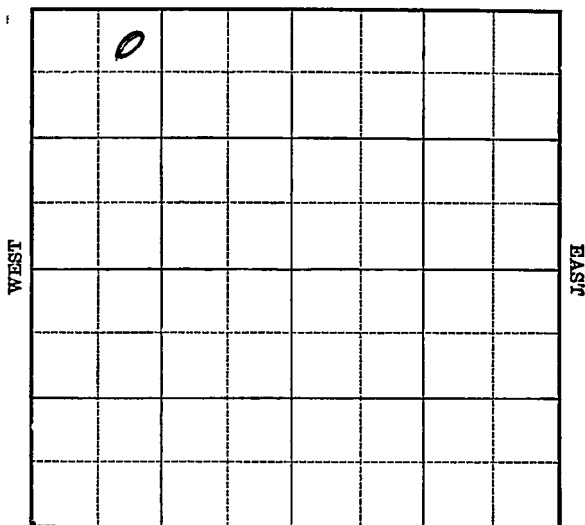

Location _____
 Drilling Remarks _____

Rig Up _____
 Drilling Remarks _____

RECORD

Cased _____ in. _____ ft.
 Sand _____
 Gas _____
 Oil _____
 Total Depth _____

PRODUCTION

1st 24 hrs. Nat. _____
 1st 24 hrs. after shot _____
 Gas _____ cu. ft.
 Dry Hole _____
 Abandoned _____

NORTH

Ft. from S. Line

Ft. from E. Line

990 Ft. from W. Line

SOUTH

Date 7/9/34

REPORT

12/5	Location
------	----------

12/13	Rig
-------	-----

12/21

12/27 Rign

1/3/35 979

1/10	11 V	2568
1/10		3918

11/7	11 2x10
1/9/14	Pl + 390

Case 2221 NL 27/12
Nimble 3587 7°3586

1/31/

2/7 T 73599, acidizing

2/14 1000 acid No Success

Re acidizing

2/20 Huntton 3589 T1 3599

1000 acid	4912 lbs
-----------	----------

COMPLETED

Map No. 40 Sec. 26 Twp. 23 R. 4 WWell No. 4 - E. KrehtilOlsen + Shell Company

Contractor

FIRST REPORTS

SECTION PLAT

330 Ft. from N. Line

Ft. from S. Line

Ft. from E. Line

990 Ft. from W. Line

0			

Location ✓

Rig up

Drilling and Remarks:

RECORD

Cased 0 in., 0 ft.

Sand

Gas

Oil

Total Depth

PRODUCTION

1st 24 hrs. Nat.

1st 24 hrs. after shot

Gas 0 Cu. Ft.

Dry Hole

Abandoned

Date

12-5-34 192 ORVAL MANNSCHRECK Scout

Map No. 40 Sec. 26 Twp. 23 R. 4WWell No. 1B- Krehbiel
Olsen & Shell Company

Contractor

CORRECTION

SECTION PLAT

0			

330 Ft. from N. Line

Ft. from S. Line

Ft. from E. Line

990 Ft. from W. Line

CORRECTION

Location

Rig up

Drilling and Remarks:

RECORD

Cased in., ft.

Sand

Gas

Oil

Total Depth

PRODUCTION

1st 24 hrs. Nat.

1st 24 hrs. after shot

Gas Cu. Ft.

Dry Hole

Abandoned

Date

ORVAL MANNSCHRECK

1-3-35 192 Scout

formerly
Reported
as #4

Map No. 40 Sec. 26 Twp. 23 R. 4W

Well No. 1B-Krehbiel

Olsen & Shell Company

Contractor

COMPLETED

SECTION PLAT

330 Ft. from N. Line

0			

Ft. from S. Line

Ft. from E. Line

990 Ft. from W. Line

Location

Rig up

Drilling and Remarks:

1000 acid

4712 lbs

RECORD

Cased in. ft.

Sand Hunton 3587

Gas

Oil

Total Depth 3599

PRODUCTION

1st 24 hrs. Nat.

1st 24 hrs. after shot

Gas Cu. Ft.

Dry Hole

Abandoned

Date

2-20-35 192

ORVAL MANNSCHRECK

Scout