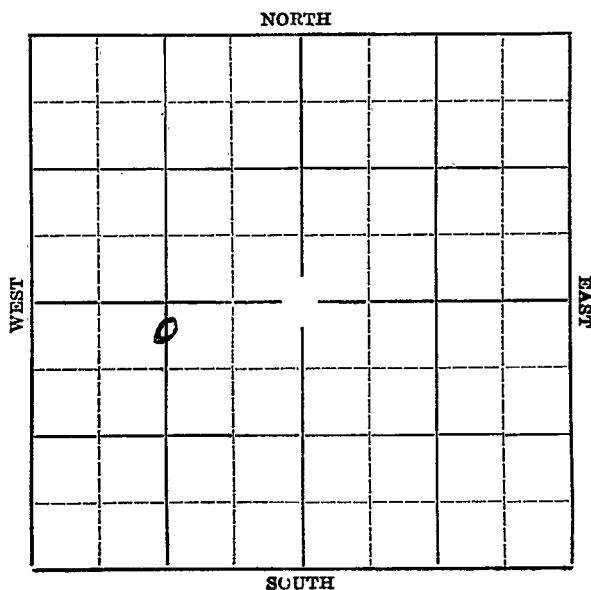
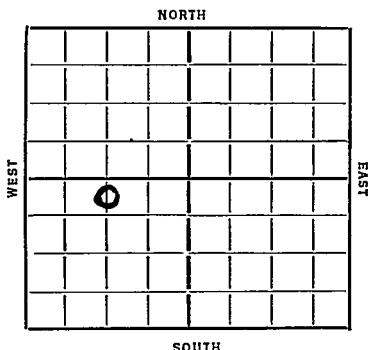


Section 26 Township 23 Range 4-WWell Number #8 Goering "A"Company Olson & Shell

Map No. KANSAS Sec. 26 Twp. 23 R. 4WWell No. #8 Goering "A" FarmOlson & Shell Company330' Ft. from N. Line Ft. from S. Line Ft. from E. Line1320' Ft. from W. Line

Elev. 1471

Date
1936

REPORT

7/15 Location

7/23 Rigging up.

7/30 15" @ 267'. Drlg. 599'.

8/6 Drlg. 2423'.

8/13 Drlg. 2923'.

8/20 Chat 3230'. 3310' fishing.

8/27 --9/3--9/10--9/18--~~9/24~~

8/24 Run 7" @ 3578'.

10/1 Hunton 3568'. 7" @ 3562'. Drlg
3575'.

10/7/36 Hunton 3568'.

T.D. 3575'.

Potential 2028 bls natural.

COMPLETED

Map No. 40 Sec. 26 Twp. 23 R. 4WWell No. J. Goering Co.Olson & Skiff. Company

Contractor

SECTION PLAT

330 Ft. from N. Line

_____ Ft. from S. Line

_____ Ft. from E. Line

1320 Ft. from W. Line

FIRST REPORT

Location ✓

Rig up _____

Drilling and Remarks:

RECORD

Cased _____ in., _____ ft.

Sand _____

Gas _____

Oil _____

Total Depth _____

PRODUCTION

1st 24 hrs. Nat. _____

1st 24 hrs. after shot _____

Gas _____ Cu. Ft.

Dry Hole _____

Abandoned _____

Date

JUL 15 1936

S. J. LEWIS Scout

Map No. 40 Sec. 26 Twp. 23 R. 4W

Well No. J. Goering A

Olson & Shell Company

Contractor

SECTION PLAT

280 Ft. from N. Line

_____ Ft. from S. Line

_____ Ft. from E. Line

1320 Ft. from W. Line

COMPLETE

Location _____

Rig up _____

Drilling and Remarks:

Hunter 3568

Pa 2028

Na Y.

RECORD

Cased _____ in., _____ ft.

Sand _____

Gas _____

Oil _____

Total Depth 3575

PRODUCTION

1st 24 hrs. Nat. _____

1st 24 hrs. after shot _____

Gas _____ Cu. Ft.

Dry Hole _____

Abandoned _____

Date

OCT 7 1935

S. J. LEWIS Scout