

KANSAS

*Reed*


Form 51-5M-11-31-Palace

Map No. \_\_\_\_\_ Sec. *26* Twp. *23* R. *4W*

Well No. *2 Krebziel* Farm \_\_\_\_\_

*Olsen-Shell-Continental* company

NORTH

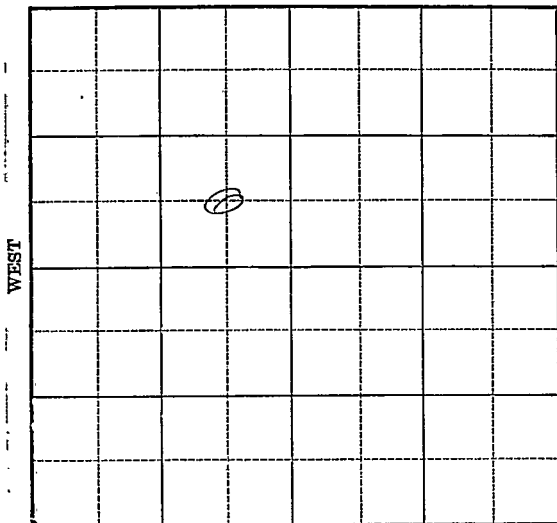

SOUTH

Location \_\_\_\_\_

Drilling Remarks \_\_\_\_\_  
\_\_\_\_\_  
\_\_\_\_\_  
Rig Up \_\_\_\_\_

Drilling Remarks \_\_\_\_\_  
\_\_\_\_\_  
\_\_\_\_\_  
RECORD

Cased \_\_\_\_\_ in. \_\_\_\_\_ ft.

Sand \_\_\_\_\_

Gas \_\_\_\_\_

Oil \_\_\_\_\_

Total Depth \_\_\_\_\_

PRODUCTION

1st 24 hrs. Nat. \_\_\_\_\_

1st 24 hrs. after shot \_\_\_\_\_

Gas \_\_\_\_\_ cu. ft. \_\_\_\_\_

Dry Hole \_\_\_\_\_

Abandoned \_\_\_\_\_



Reno

W

40 KANSAS Map No. Sec. 76 Twp. 23 R. 4

Well No. 7 E. Krehbiel

Olson - Shee &amp; Continental Company

Contractor

## FIRST REPORTS

..... Ft. from N. Line

660 Ft. from S. Line

660 Ft. from E. Line

..... Ft. from W. Line

## SECTION PLAT

	o		

Location..... ✓

Rig up.....

Drilling and Remarks:

## RECORD

Cased..... in., ..... ft.

Sand.....

Gas.....

Oil.....

Total Depth.....

## PRODUCTION

1st 24 hrs. Nat.....

1st 24 hrs. after shot.....

Gas..... Cu. Ft.

Dry Hole.....

Abandoned.....

Date

MAR 2 2 1933

192

CHAS. L. SHERWOOD

Scout

Reno

W

Map No. **KANSAS**

Sec. 26 Twp. 23 R. 4

Well No. 2 E. Krehkies

Olsew. Dheel & Continental Company

Contractor

**COMPLETED**

**SECTION PLAT**

	0		

.....Ft. from N. Line  
660 Ft. from S. Line  
660 Ft. from E. Line  
 .....Ft. from W. Line

Location.....  
 Rig up.....  
 Drilling and Remarks:

**RECORD**

Cased 8 in., 3238 ft.  
 Sand Chat 3233-3310  
 Gas.....  
 Oil.....  
 Total Depth 3310

**PRODUCTION**

1st 24 hrs. Nat.....  
 1st 24 hrs. after shot.....  
 Gas 25.14 Cu. Ft.  
 Dry Hole.....  
 Abandoned.....

Date **MAY 3 1933**

**CHAS. L. SHERWOOD**