


Map No. KANSA Sec. 26 Twp. 23 R. 4W
 Well No. 4 Krehbiel Farm _____
Olsen - Shell Company _____

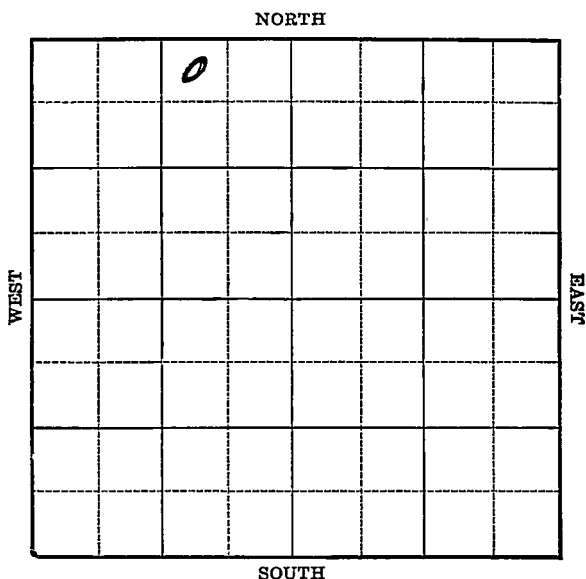

Location _____
 Drilling Remarks _____

Rig Up _____
 Drilling Remarks _____

RECORD

Cased _____ in. _____ ft.
 Sand _____
 Gas _____
 Oil _____
 Total Depth _____

PRODUCTION

1st 24 hrs. Nat. _____
 1st 24 hrs. after shot _____
 Gas _____ cu. ft. _____
 Dry Hole _____
 Abandoned _____

Reno


Map No. KANSAS Sec. 26 Twp. 23 R. 4W
Well No. 4 Krehbiel Farm
Olson - Shell Company

330 Ft. from N. Line

_____ Ft. from S. Line

990 Ft. from E. Line

_____ Ft. from W. Line

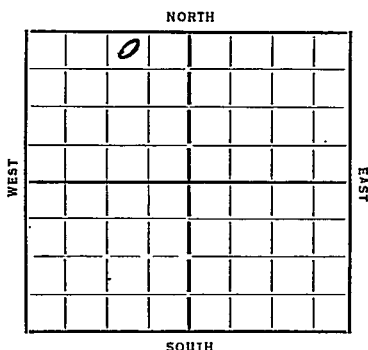

Date 1935 REPORT

1/2 Location -
1/17 Rgn up.
1/24 1387 15" 263
1/31 " 2683
2/7 " 3333 Chit 3252
2/14 " 3510 Base line 3500
2/21 Hutton 3592 T7 3597 Rust
2/28 T7 3614 flow 60 Bbls per hr
3/6 Hutton 3592 T7 3614
1000 acid 2901 Bbls.

COMPLETED

Map No. 40 Sec. 26 Twp. 23 R. 4W

Well No. 4-Krehbiel

Olson-Shell Company

Contractor

SECTION PLAT

FIRST REPORTS

330 Ft. from N. Line

_____ Ft. from S. Line

990 Ft. from E. Line

_____ Ft. from W. Line

	0		

Location ✓

Rig up _____

Drilling and Remarks:

RECORD

Cased _____ in., _____ ft.

Sand _____

Gas _____

Oil _____

Total Depth _____

PRODUCTION

1st 24 hrs. Nat. _____

1st 24 hrs. after shot _____

Gas _____ Cu. Ft.

Dry Hole _____

Abandoned _____

Date

1-2-35 192 ORVAL MANNSCHRECK Scout

Map No. 40 Sec. 26 Twp. 23 R. 4W

Well No. 4-Krehbiel

Olsen & Shell Company

Contractor

COMPLETED

SECTION PLAT

330 Ft. from N. Line

..... Ft. from S. Line

990 Ft. from E. Line

..... Ft. from W. Line

	0		

Location.....

Rig up.....

Drilling and Remarks:

1000 acid

2901 lbs

RECORD

Cased..... in., ft.

Sand Hunter 3592

Gas.....

Oil.....

Total Depth 3614

PRODUCTION

1st 24 hrs. Nat.....

1st 24 hrs. after shot.....

Gas..... Cu. Ft.

Dry Hole.....

Abandoned.....

Date

ORVAL MANNSCHRECK

3-6-35

192.....

Scout