


Map No. KANSAS Sec. 26 Twp. 23 R. 4W

Well No. 5-Krehbiel Farm
Olson & Shell Company

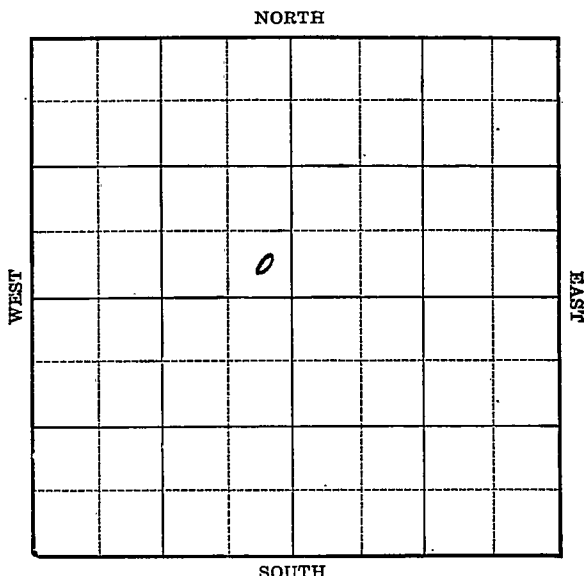

Location _____

Drilling Remarks _____

RECORD

Cased _____ in. _____ ft.

Sand _____

Gas _____

Oil _____

Total Depth _____

Rig Up _____

Drilling Remarks _____

PRODUCTION

1st 24 hrs. Nat. _____

1st 24 hrs. after shot _____

Gas _____ cu. ft.

Dry Hole _____


Abandoned _____

Reno

Map No. KANSAS Sec. 26 Twp. 23 R. 4^W

Well No. 5- Krehbiel Farm
Olsen & Shell Company

NORTH

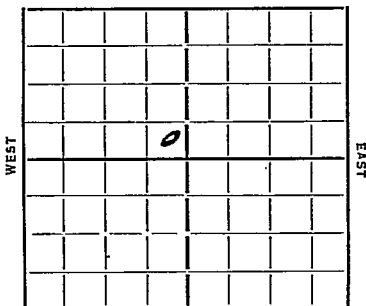

SOUTH

_____ Ft. from N. Line

330 Ft. from S. Line

330 Ft. from E. Line

_____ Ft. from W. Line

Date

REPORT

1935
3/30 Location
3/28 — 4/4 —
4/11 12" 493
4/18 Dlg 2170
4/26 " 2986
5/2 Dlg 3455 Chat 3231
5/9 Mir 3572 8" 4 3571 Rust
5/15 Hunter 3575 T 2 3583
809 Oil 350 water

COMPLETED

Map No. 40 Sec. 26 Twp. 23 R. 4W

Well No. 5-Krehbiel

Olsen & Shell Company

Contractor

FIRST REPORTS

Ft. from N. Line

330 Ft. from S. Line

330 Ft. from E. Line

Ft. from W. Line

SECTION PLAT

	0		

Location ✓

Rig up

Drilling and Remarks:

RECORD

Cased in., ft.

Sand

Gas

Oil

Total Depth

PRODUCTION

1st 24 hrs. Nat.

1st 24 hrs. after shot

Gas Cu. Ft.

Dry Hole

Abandoned

Date

ORVAL MANNSCHRECK

3-20-35 192

Scout

Map No. 40 Sec. 26 Twp. 23 R. H.W.Well No. 5-15 rebbidOlsen & Shell Company

Contractor

COMPLETED

SECTION PLAT

Ft. from N. Line

330 Ft. from S. Line330 Ft. from E. Line

Ft. from W. Line

Location

Rig up

Drilling and Remarks:

809 oil
350 water

RECORD

Cased _____ in., _____ ft.

Sand Hunter 3575

Gas _____

Oil _____

Total Depth 3583

PRODUCTION

1st 24 hrs. Nat. _____

1st 24 hrs. after shot _____

Gas _____ Cu. Ft.

Dry Hole _____

Abandoned _____

Date

ORVAL MANNSCHRECK

5-15-35 192 Scout