


Rino

Map No. **KANSAS** Sec. *26* Twp. *23* R. *4* ^{*W*}

Well No. *2 Vag* Farm _____
Olson + Schell Company _____

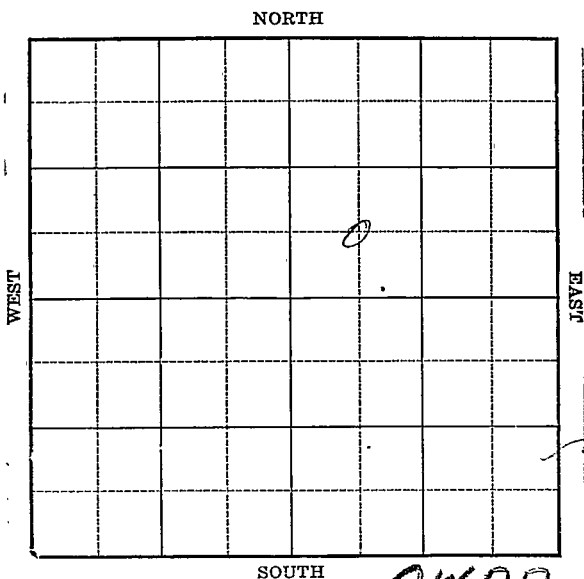

Location _____

Drilling Remarks _____

Rig Up _____

Drilling Remarks _____

RECORD

Cased _____ in. _____ ft.

Sand _____

Gas _____

Oil _____

Total Depth _____

PRODUCTION

1st 24 hrs. Nat. _____

1st 24 hrs. after shot _____

Gas _____ cu. ft. _____

Dry Hole _____

Abandoned _____

Rena


Map No. KANSAS Sec. 26 Twp. 23 R. 40
Well No. 2 Hoght Farm
Olsen & Shell Company

 Ft. from N. Line

660' Ft. from S. Line

 Ft. from E. Line

660' Ft. from W. Line

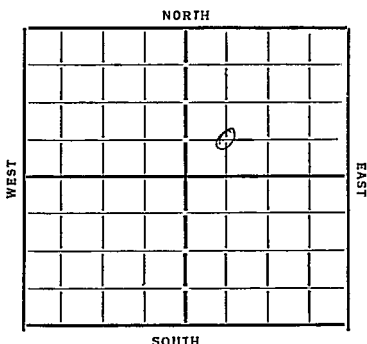

Date 1933

REPORT

12/13

12/27 *Rig*

1/11 — 1/17 — 1/24 — 1/31 —

2/2 —

2/14 *Drily 120*

2/23 " *1232 15 1/2 at 252*

3/1 " *2365*

3/8 " *2499 12" 495*

3/15 *SD 3192*

3/22 *Chat 3242 8" 3250 Rust 3251*

3/29 *GD 3310 15 M Gas*

4/11 *Chat 3242 TD 3310*

9 1/2 M Gas.

COMPLETED

1934

OWDD

4/25 *OTD 3310*

Moving in

5/3 *5" 3234 Cased off 28 M Gas*

5/9 *TD 3375 266 Bbls oil 29 M Gas*

COMPLETED

Map No. 40 Sec. 26 Twp. 23 R. 4W

Well No. 2-7097

Olsen-Skill Company

Contractor

FIRST REPORTS

Ft. from N. Line

660 Ft. from S. Line

Ft. from E. Line

660 Ft. from W. Line

SECTION PLAT

		0	

Location

Rig up

Drilling and Remarks:

Material

RECORD

Cased in., ft.

Sand

Gas

Oil

Total Depth

PRODUCTION

1st 24 hrs. Nat.

1st 24 hrs. after shot

Gas Cu. Ft.

Dry Hole

Abandoned

Date

12-13-33 192 O. Mammerschick Scout

Map No. 40 Sec. 26 Twp. 23 R. 4WWell No. 2-V optOlsen - Shell Company

Contractor

COMPLETED

SECTION PLAT

Ft. from N. Line

660 Ft. from S. Line

Ft. from E. Line

660 Ft. from W. Line

		0	

Location

Rig up

Drilling and Remarks:

9 1/2 mil
902

RECORD

Cased _____ in. _____ ft.

Sand Chat 3242

Gas _____

Oil _____

Total Depth 3310-

PRODUCTION

1st 24 hrs. Nat. _____

1st 24 hrs. after shot _____

Gas _____ Cu. Ft.

Dry Hole _____

Abandoned _____

Date

4-11-34 192 O. Mannschreck Scout

KANSAS

Map No. 40 Sec. 26 Twp. 23 R. 4W

Well No. 2-Vogts

Olsen-Shell Company

Contractor

FIRST REPORTS

 Ft. from N. Line

660 Ft. from S. Line

 Ft. from E. Line

660 Ft. from W. Line

Q W N W

SECTION PLAT

		0	

Location

Rig up

Drilling and Remarks:

OTU 3310

Moving in

RECORD

Cased in., ft.

Sand

Gas

Oil

Total Depth

PRODUCTION

1st 24 hrs. Nat.

1st 24 hrs. after shot

Gas Cu. Ft.

Dry Hole

Abandoned

Date

4-25-31 19

ORVAL MANNSCHRECK

Scout

Map No. 40 Sec. 26 Twp. 23 R. 4N

Well No. 2-7045

Olsen-Snell Company

Contractor

COMPLETED

SECTION PLAT

		0	

 Ft. from N. Line

60 Ft. from S. Line

 Ft. from E. Line

660 Ft. from W. Line

OWN

Location

Rig up

Drilling and Remarks:

266 ft. oil
29 mil gas

RECORD

Cased in., ft.

Sand

Gas

Oil

Total Depth 3375

PRODUCTION

1st 24 hrs. Nat.

1st 24 hrs. after shot

Gas Cu. Ft.

Dry Hole

Abandoned

Date

5-7-34 19

ORVAL MANNSCHRECK

Scout