

KANSAS


Stafford County

FORM 51 5M BRIX

Section 26 Township 23 Range 11W

Well No. #1 Krey

Company Republic Nat. Gas

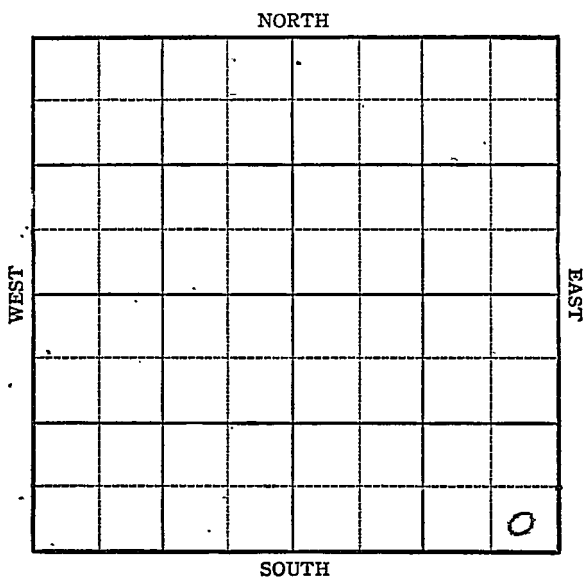

KANSAS

Sec. 26 Twp. 23S- R. 11W

Well No. #1, Krey Farm

Republic Nat. Gas Company

Zenith

 Ft. from N. Line

330

 Ft. from S. Line


330

 Ft. from E. Line

 Ft. from W. Line

SE/c

Elev. 1802

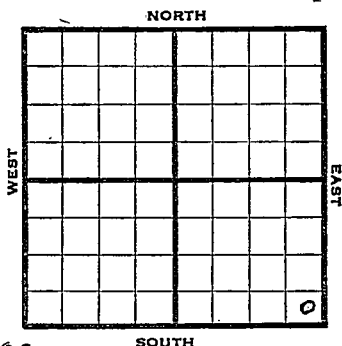

1945

R E P O R T

1-10

10" @ 336'

Drilling 1475

1/17

Drlg 3020

1/24

Viola 3684

Arb. 3866

TD 3868

ABANDONED

Pool Name ZenithMap No. 47 Sec. 26 Twp. 23 R. 11WWell No. 1 Krey

Republic Nat. Gas


Company

FIRST REPORT

Contractor

SE/c

SECTION PLAT

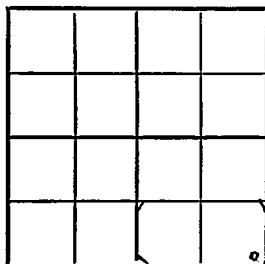

Ft. from N. Line

330 Ft. from S. Line330 Ft. from E. Line

Ft. from W. Line

Stafford

Location

Rig up

Drilling and Remarks:

10-336

1475

RECORD

Cased _____ in., _____ ft.

Sand _____

Gas _____

Oil _____

Total Depth _____

PRODUCTION

1st 24 hrs. Nat. _____

1st 24 hrs. after shot _____

Gas _____ Cu. Ft.

Dry Hole _____

Abandoned _____

Date

JAN 10 1945

19

S. J. LEWIS

Scout

Pool Name ZenithMap No. K-47 Sec. 26 Twp. 23 R. 11WWell No. 1 KreyRepublic Nat. Gas CompanyABANDONED Contractor

SE/c

SECTION PLAT

 Ft. from N. Line330 Ft. from S. Line330 Ft. from E. Line Ft. from W. Line

			a

StaffordLocation Rig up

Drilling and Remarks:

Vista 3684Ar 73866

RECORD

Cased in. ft.Sand Gas Oil Total Depth 3868

PRODUCTION

1st 24 hrs. Nat. 1st 24 hrs. after shot Gas Cu. Ft.Dry Hole Abandoned

Date

JAN 24 1945 19S. J. LEWIS Scout