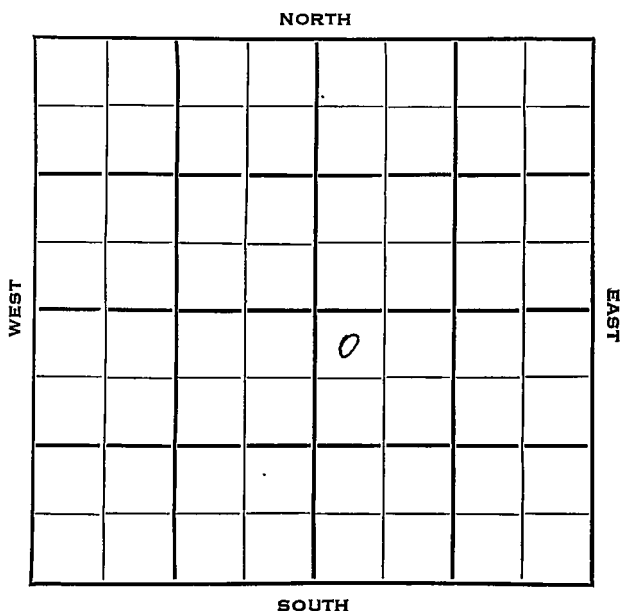


Section 26 Township 23 Range 12 WWell No. # 1 LambCompany Trans-Era

Stafford KANSAS

SEC.	TWP.	R.
26	23	12W ✓

WELL NO.

1 Lamb

FARM

COMPANY

Trans-Era

CONTRACTOR

Trans-Era

Wildcat

330


Ft. from N. Line

Ft. from S. Line

Ft. from E. Line

330

Ft. from W. Line

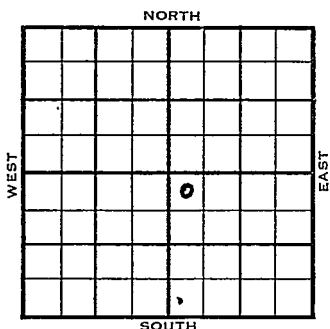

NW NW SE

Texas & Skelly DHM

	ELEVATION	REPORT
1954	1852'	

3/31	MIR
4/7	8" @ 246'
	Anhy 633'
	Drlg 3015'
4/14	Spud 3-30-54
	D&A
	TD 3938'
	8" @ 246'
	Anhy 633', Heeb 3235', Br 1m 3377',
	KC 3409', Viola 3764', Simp 3826'
	DST 3740-68', opn 1 hr., rec. 10' mud,
	DST 3818-40', opn 8", pkr failed, rec.
	290' mud, Off
	Arb. 3883'
	TD 3938'
	D&A

ABANDONED

County **Stafford** State **Kansas**

Sec. 26 (Blk. Twp.) 23 (Sur. Rge.) 12W Map No.

Operator Trans-Era

Well No. 1 Farm Lamb

Elev.	Location	WY	NY	SR
-------	----------	----	----	----

FIRST REPORT

330 Ft. From N Line SE

330 Ft. From W Line Quarter

1st. Report MAR 31 1954

Completion

Remarks Texas & Skelly - DHM
Trans-Era - Contr.


Spudding Date

Drlg. Data Wildcat

MEMO

J. G. McGEHEE

County Stafford State Kansas
 Sec. 26 (Blk.) 23 (Sur.) 12W Map No.
 Operator Trans-Era
 Well No. 1 Farm Lamb
 Elev. 1852 Location NW NW SE

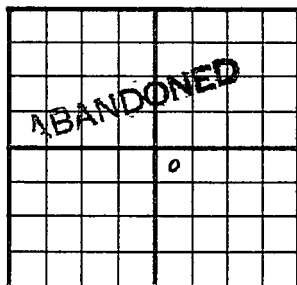

330 Ft. From N Line SE
330 Ft. From W Line Quarter
 Ist. Report
 Completion APR 14 1954
 Remarks Wildcat
Trans-Era - Contr.
 Spudding Date 3-30-54

Drlg. Data D & A TD 3938
8" @ 246 Anhy 633 Heeb. 3235
Br. lime 3377 KC 3409 Viola 3764
Simp. 3826 DST 3740-68 open 1 hr.
Rec. 10' mud DST 3818-40 open 8 min,
packer failed Rec. 290' mud 0#
Arb. 3883.4 TD 3938

D & A

J. G. McGEHEE