


Section 26 Township 23 Range 14W

Well No. #1 Goen

Company Welch & Olsson

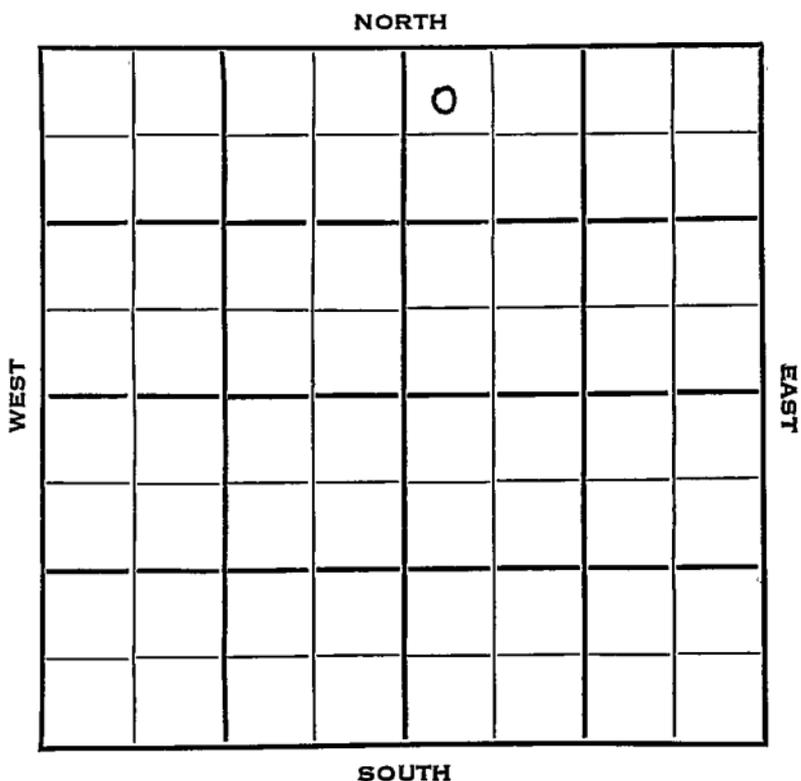

Stafford

KANSAS

SEC. 26	TWP. 23	R. 14W
------------	------------	-----------

WELL NO. #1 Coen FARM

COMPANY Welch & Olsson


CONTRACTOR Welch & Olsson

330 Radke Pool
Ft. from N. Line

Ft. from S. Line

Ft. from E. Line

330 Ft. from W. Line

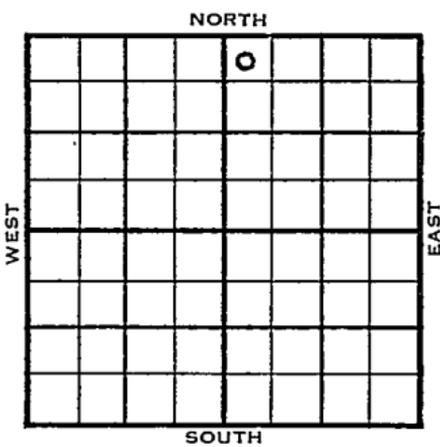

NW NW NE
Derby F/O
Phillips support

1953	ELEVATION 1924'	REPORT
------	--------------------	--------

9/2 Spud 8-30-53
8" @ 215'
Drlg 1775'

9/9 Heeb 3408' Br li 3547' Lans 3562
Drlg. 3773'

9/16 Spud 8-30-53
D & A
TD 4073'
8" @ 215'
Heeb 3408, Br. Lime 3547, Lans 3562
B KC 3805, Cong 3900, Viola 3919,
Simp 3977, Arb 4044
TD 4073'
D & A

ABANDONED

County Stafford State Kansas

Sec. 26 (Blk. 23) (Sur. 14W) (Twp. 23) (Rge. 14W) Map No.

Operator Welch & Olsson

Well No. 1 Farm Coen

Elev. _____ Location NE 1/4 Sec 26 T23 R14W

		0			
FIRST REPORT					

330 Ft. From N Line NE

330 Ft. From W Line Quarter

1st. Report SEP 2 1953

Completion _____

Remarks Derby farmout
Phillips support

Welch & Olsson - Contr.

Spudding Date 8-30-53

Drlg. Data Radke Pool

8" @ 215 drlg. 1775


County Stafford State Kansas

Sec. 26 (Blk. 23 (Sur. 14W Map No.
(Twp.) (Rge.)

Operator Welch & Olsson

Well No. 1 Farm Coen

Elev. 1924 Location NW NW NE

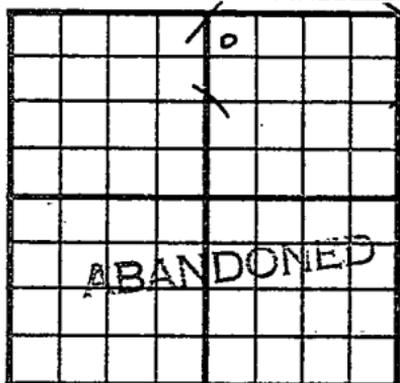

330 Ft. From N Line NE

330 Ft. From W Line Quarter

Ist. Report

Completion SEP 16 1953

Remarks Radke Pool

Welch & Olsson - Contr.

Spudding Date 8-30-53

Drlg. Data D & A TD 4073

8" @ 215 Heeb. 3408 Br. lime 3547

Lans. 3562 B KC 3805 Cong. 3900

Viola 3919 Simp. 3977 Arb. 4044

TD 4073

D & A