


Pawnee

KANSAS

SECTION 26 TOWNSHIP 23 RANGE 15W

WELL NO. #1 Walker

COMPANY Natural Gas & Oil

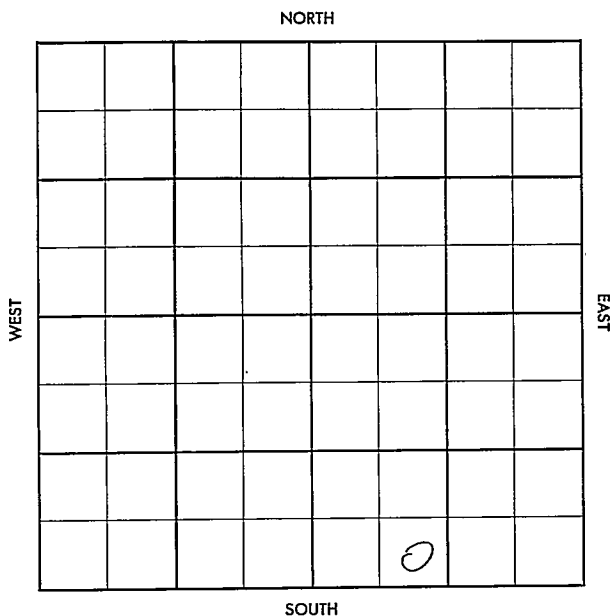

SEC. 26	TWP. 23	R. 15W
------------	------------	-----------

WELL NO.

#1 Walker

FARM

COMPANY

Natural Gas & Oil

CONTRACTOR

Peel

Hearn


_____ Ft. from N. Line

_____ Ft. from S. Line

_____ Ft. from E. Line

_____ Ft. from W. Line

SE SW SE

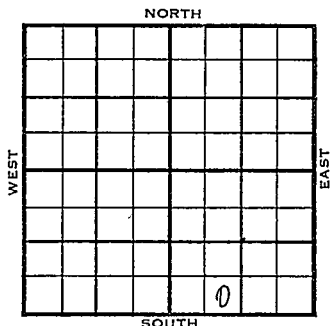

1956

ELEVATION

2002'

REPORT

4-25

Comm. 4-14-56

8" @ 218 w/220

DST 3817-38 op 1 hr. rec. 30' mud, 0#15

DST 3988-4040 op 1 hr. rec. 20' mud,
360/15"DST 4074-4120 op 1 hr. rec. 180' GIP,
15'mud, 0#

5-29

DST 4130-35 op 1 hr. rec. 844' gas /
394' oil / 122' HO&GCM, BHP 1110#.

5 1/2" @ 4130/100

CO 4135

FU 300' oil

S/ 64 BO / tr. wtr., 3 hrs.

SI, FU 700' oil / 400' wtr.

Sqd., CO 4135

B/ 10 GOPH, no/w.

B/ 5 GFPH

S/ 7.6 BO in 30 min. ~~XXXX~~ 700' O.B

P/ 25 BOPD / 60% wtr., Grav. 36.

Anh. 933-52'; H. 3481'; L. 3623',

BKC 3870', C. 3985', V. 4033',

S. 4075', A. 4129'.

TD 4135'

COMPLETED

County Pawnee Elev. _____
 Sec. 26 Twp. 2 Rge. 15W
 Company Natural Gas & Oil
 Farm Name Walker No. 1

TOPS	DEPTH	LOG	DATUM
Anb.			
Tr.			
H.			
Tr.			
Dg.			
Bl.			
L.			
K.C.			
B.K.C.			
Ce.			
C.			
M.			
M.			
K.			
Mz.			
Me.			
V.			
S.			
S.			
A.			
R.			
Pe.			
G.			
T.D.			

Loc. in Sec. _____

SE SW SE

Geol. _____

Contr. _____

Peel

Pool

Hearn

FIRST REPORT

APR 25 '56

Date Comm. 4-14-56

8" @ 218/220 DST 3817-38 open 1 hr.

rec. 30" mud 0#/15" DST 3 988-4040

open 1 hr. rec. 20" mud 360/15"

DST 4074-4120 open 1 hr. rec. 180" GTP

15" mud 0#

8221 S YAM

D.R.

13

FORM 513 SUNRAY

County Pawnee Elev. 2002
 Sec. 26 Twp. 23 Rge. 15W
 Company Natural Gas & Oil
 Farm Name Walker No. 1

TOPS	DEPTH	LOG	DATUM	Loc in Sec.
Anb.	933-52			SE SW SE
Tr.				
H.	3481			
Tr.				
Dg.				
BL				
L.	3623		1621	Geol.
K.C.				
B.K.C.	3870		1868	Contr.
Ce.				
C.	3985		1983	Peel
M.				
M.				Pool
K.				Hearn
Mz.				
Mo.				
V.	4033		2031	
S.	4075		2073	
S.				
A	4129	4125	2127	COMPLETE
R.				
Pe.				
G.				
TD.	4135			

Date Comm. 4-14-56 MAY 29 1956

8" @ 218/220 DST 3817-38 open 1 hr.
 rec. 30' mud 0#/15" DST 3988-4040
 open 1 hr. & rec. 20' mud 360/15"
 DST 4071-4120 open 1 hr. rec. 180' gas
 15' mud 0# MAY 2 '56 DST 4130-35
 1hr rec 844 gas + 394' oil
 +122' HO & GCM BHP 1110 5 1/2 @
 4130/100 MAY 9 '56 CO 4135 TD FU
 300' oil & 6480 + Tr. into 3 hrs

S.I. FU 700' si' + 400 wtr
Sed CO 4135 B 10 Goph
no/w B 5 GFph 1/2 MAY 16 '56
\$ 7.6 BO in 30" 700' O.B
ROR MAY 23 '56 MAY 29 '56 Ph P. 25
Bopd + 60 90 wtr grow
36°