


KANSAS

Finney

Section 26 Township 23 Range 34-W

Well No. #1 Garden City "K"

Company Cities Service

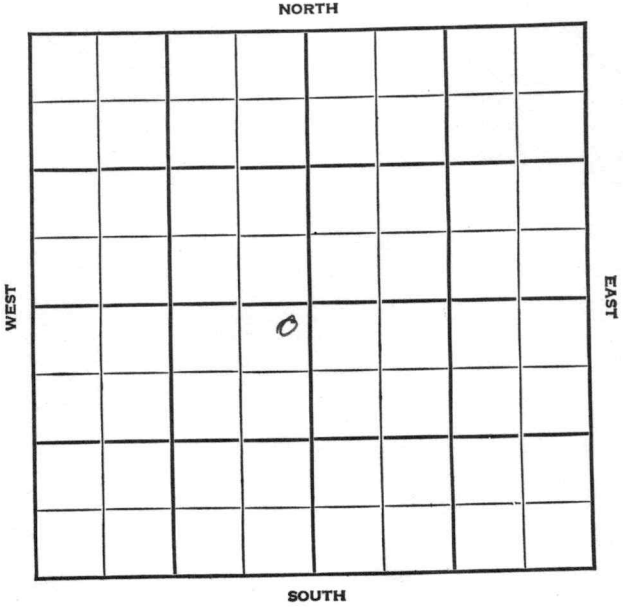

KANSAS

Finney

Sec. 26 Twp. 23 R. 34W

Well No. #1 Garden City "K" Farm

Cities Service Company

Hugoton Pool


100' Ft. from N. Line

 Ft. from S. Line

100' Ft. from E. Line

 Ft. from W. Line

NE SW

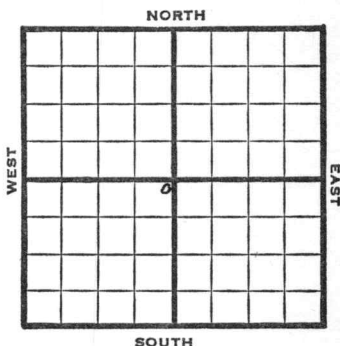

1948	Eli 2946'	REPORT
7/8	Location	
7/14	"	
7/21	"	
7/28	RUR	
8/4	8" @ 800'	
	Dr1g. 2470'	
8/11	TD 2642'	
	5"@ 2640'	
8/18	120 shots 2606-30'	
	50 shots 2592-2602'	8000 acid
8/25	110 shots 2536-58	
	90 shots 2498-2516'	
	40 shots 2484-92	18000 acid
9/1	"	
9/8	"	
9/15	5"@ 2640'	
	TD 2 642'	
	Perf 30000 acid	
	2,590,000 Gas	
	422# R Pr.	
	Comp	
	COMPLETED	

Map No. _____ Sec. 26 Twp. 23 R. 34W

Well No. 1 Garden City "K"

Cities Service

Company

FIRST REPORT

Contractor

NE SW


SECTION PLAT

100 Ft. from N. Line

_____ Ft. from S. Line

100 Ft. from E. Line

_____ Ft. from W. Line

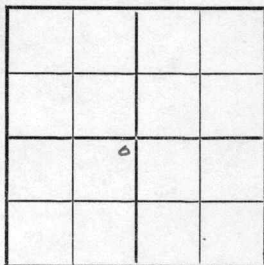

Finney County

Location X

Rig up _____

Drilling and Remarks: _____

RECORD

Cased _____ in., _____ ft.

Sand _____

Gas _____

Oil _____

Total Depth _____

PRODUCTION

1st 24 hrs. Nat. _____

1st 24 hrs. after shot _____

Gas _____ Cu. Ft.

Dry Hole _____

Abandoned _____

Date

JUL 8 1948 S. J. LEWIS Scout

Finney County Kansas State

Map No. _____ Sec. 26 Twp. 23 R. 34W

Well No. 1 Garden City "K"

Cities Service Company

COMPLETE

Contractor

NE SW

E12946

SECTION PLAT

100 Ft. from N. Line

_____ Ft. from S. Line

100 Ft. from E. Line

_____ Ft. from W. Line

Hugoton Pool

Remarks:

5-11-2640

7-17-2642

Prof.

3000000000

2,590,000 Gas

422 # R/L

Date
SEP 15 1948

Scout **S. J. LEWIS**