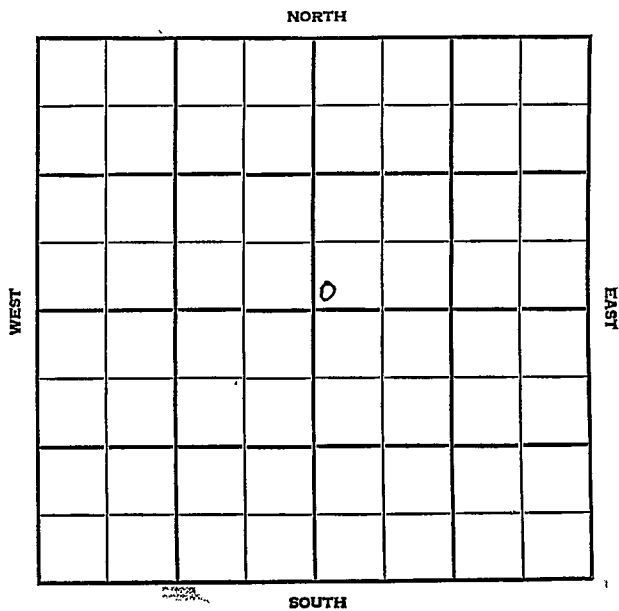


Section 26 Township 23 Range 38 WWell No. #1 Snider Gas Unit "C"Company Stanolind

Kearny

KANSAS

SEC.	26	TWP.	23	R.	38W
------	----	------	----	----	-----

WELL NO.

1 Snider Gas Unit "C"

FARM

COMPANY

Stanolind

CONTRACTOR

Noble

Hugoton

Ft. from N. Line

150


Ft. from S. Line

Ft. from E. Line

150

Ft. from W. Line

SW SW NE

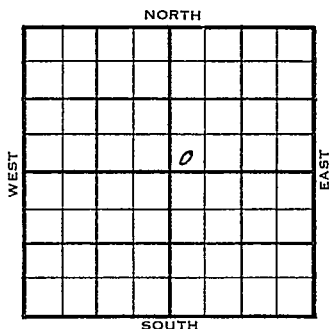

1955	ELEVATION 3340 RB 3337 DF	REPORT
------	---------------------------------	--------

9-14 Location

10/26 Comm 9-13-55
 8 5/8" @ 875/500
 5 1/2" @ 2728/1000
 Herr Kri 2600
 Winf 2653
 Tow 2717
 CO 24/2653-59 12/2661-64
 24/2668-74 16/2682-86 12/2695-98
 12/2700-03 232 mcfg frac 3,426
 mcfg SP 2636 40/2602-12 24/2614-
 20 24/2624-32 CO 2708 frac
 Comp F 9,313 mcfgpd 352#

COMPLETED

County Kearny

Elev.

3340 RB

3337 DF

Sec. 26

Twp.

23

Rge.

38W

Company Stanolind

Farm Name

Snider Gas Unit. "G"

No.

TOPS

DEPTH

LOG

DATUM

Loc. in Sec.

Anh.

Tp.

H.

Tr.

Dg.

Bl.

L.

K.C.

B.K.C.

Ce.

C.

M.

M.

K.

Mz.

Mq.

V.

S.

S.

A.

R.

PE.

G.

T.D.

SW SW NE

150' SL

150' WL

Geol.

Contr.

Noble

Pool

Hugoton

FIRST REPORT

SEP 14 '55

Date Comm.

Location

34

County

Kearny

Elev.

3340 RD
3337 DF

Sec.

26

Twp.

23

Rge.

38W

Company

Stanolind

Farm Name

Snider Gas Unit "C"

No.

1

TOPS	DEPTH	LOG	DATUM	Loc. in Sec.
Anh.				SW SW NE
Tp. <i>Versu-Kri</i>	2600			
H. <i>Wing</i>	2653			150' SL
Tr. <i>Lawn</i>	2717			150' WL
Dg.				
Bl.				
L.				
K.C.				Geol.
B.K.C.				Contr.
Ce.				
C.				Noble
M.				
M.				Pool
K.				Hugoton
Mz.				
Mq.				
V.				
S.				
S.				
A.				
R.				
PE.				
G.				
T.D.	2730			COMPLETE

Date Comm.

9-13-55

OCT 26 1955

8 5/8" @ 875/500 5 1/2" @ 2728/1000

CO 24/ 2653-59 12/ 2661-64

24/ 2668-74 16/ 2682-86 12/ 2695-98

12/ 2700-03 232 mcfg frac 3,426 mcfg

SP 2636 40/ 2602-12 24/ 2614-20

24/ 2624-32 CO 2708 frac

Comp. F. 9,313 mcfgpd 352#