


Map No. KANSAS Sec. 27 Twp. 23 R. 4<sup>th</sup> *Reno*Well No. 1- Penner FarmOlsen & Shell Company

NORTH

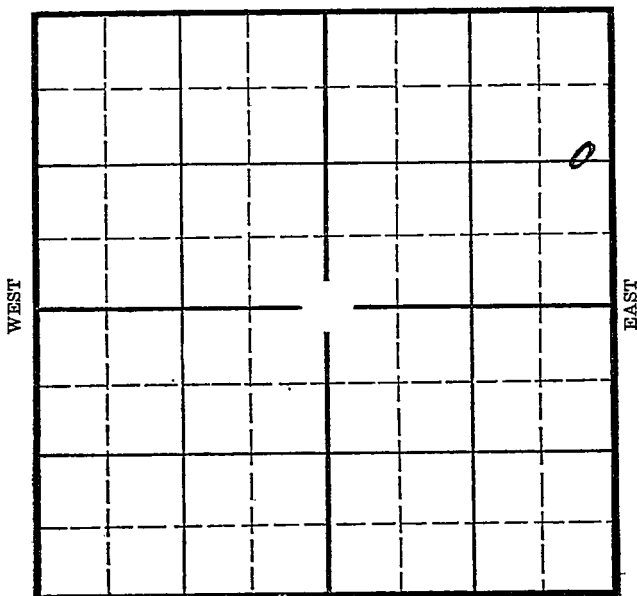

SOUTH

Location \_\_\_\_\_

Drilling Remarks \_\_\_\_\_

Rig Up \_\_\_\_\_

Drilling Remarks \_\_\_\_\_

## RECORD

Cased \_\_\_\_\_ in. \_\_\_\_\_ ft.

Sand \_\_\_\_\_

Gas \_\_\_\_\_

Oil \_\_\_\_\_

Total Depth \_\_\_\_\_

## PRODUCTION

1st 24 hrs. Nat. \_\_\_\_\_

1st 24 hrs. after shot \_\_\_\_\_

Gas \_\_\_\_\_ cu. ft. \_\_\_\_\_

Dry Hole \_\_\_\_\_

Abandoned \_\_\_\_\_

Reno

KANSAS

Map No. \_\_\_\_\_ Sec. 27 Twp. 23 R. 4W

Well No. 1- Penner Farm \_\_\_\_\_

Olson & Shell

Company

NORTH

1320 Ft. from N. Line

\_\_\_\_\_ Ft. from S. Line

330 Ft. from E. Line

\_\_\_\_\_ Ft. from W. Line

Elevation 1471

|  |  |  |  |  |  |  |  |  |  |
|--|--|--|--|--|--|--|--|--|--|
|  |  |  |  |  |  |  |  |  |  |
|  |  |  |  |  |  |  |  |  |  |
WEST

EAST

SOUTH

REPORT

Date 1935  
12/30 Rot Rig  
1/10/36 12" 258 WOC  
1/17 Dlg 2192  
1/24 3118  
1/31 Top Chat 3246 7" 3276  
2/7 Running  
2/7 7M Gas 3310-14 TD 3317  
2/14 Running 5"  
2/14 5" 3317 Dlg ahead  
2/21 TD 3370 Est 25 Bbls  
2/26 Will acidize  
2/26 Chat 3246  
2/26 TD 3370  
2/26 1000 acid  
2/26 Pot 164 Dil

COMPLETED

KANSAS

Map No. 40 Sec. 27 Twp. 23 R. 4WWell No. 1-RunnerOlson + Shell Company

Contractor

## FIRST REPORTS.

## SECTION PLAT

1320 Ft. from N. Line

.....Ft. from S. Line

330 Ft. from E. Line

.....Ft. from W. Line

|  |  |  |  |
|--|--|--|--|
|  |  |  |  |
|  |  |  |  |
|  |  |  |  |
|  |  |  |  |
|  |  |  |  |

Location.....

Rig up.....

Drilling and Remarks:

Rot Rig

## RECORD

Cased.....in., .....ft.

Sand.....

Gas.....

Oil.....

Total Depth.....

## PRODUCTION

1st 24 hrs. Nat.....

1st 24 hrs. after shot.....

Gas.....Cu. Ft.

Dry Hole.....

Abandoned.....

Date

ORVAL MANNSCHPECK

12-30-35 192.....Scout

KANSAS

Map No. 40 Sec. 27 Twp. 23 R. 4w

Well No. 1 - Penner

Alson & Shell Company

Contractor

COMPLETED

SECTION PLAT

1320 Ft. from N. Line

..... Ft. from S. Line

330 Ft. from E. Line

..... Ft. from W. Line

|  |  |  |   |
|--|--|--|---|
|  |  |  |   |
|  |  |  | 0 |
|  |  |  |   |
|  |  |  |   |
|  |  |  |   |

Location.....

Rig up.....

Drilling and Remarks:

1000 and

for 164 oil

RECORD

Cased..... in., ..... ft.

Sand chert 3246

Gas.....

Oil.....

Total Depth 3370

PRODUCTION

1st 24 hrs. Nat.....

1st 24 hrs. after shot.....

Gas..... Cu. Ft.

Dry Hole.....

Abandoned.....

Date

FEB 26 1936

ORVAL MANNSCHRECK

Scout