

Map No. _____ Sec. 27 Twp. 23 R. 4-W


Well No. 1-Querfeld Farm _____
Olsen + Shell Company

_____ Ft. from N. Line

660 Ft. from S. Line

_____ Ft. from E. Line

660 Ft. from W. Line

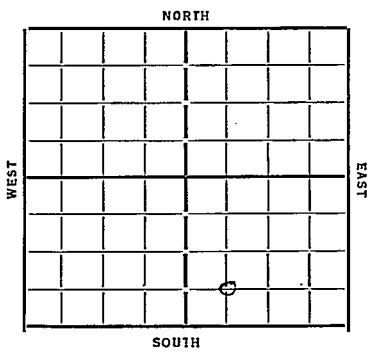

Date 1933

REPORT

6/21 location

6/27 _____

7/5 12"-363'

7/12 dry 3190'

7/19 " 3137

7/26 Top Chat 3297 dry 3311

8/2 Rent

8/9 ~~dry 3546~~ Rent

8/17 N. 7.10 3495 dry

8/23 6" 3520 dry 3538'

8/30 B.L. 3595 T.H. 3675 N. 7.10 3689 T.D. 3695

feathering

9/6 Huntton 3675-3695

D. + a. 3695

ABANDONED

1934 OWDD O.W.D.D.

1/10 Drilling deeper

6/14 Huntton 3675 TD 3695 D + A

ABANDONED

Map No. 40 Sec. 27 Twp. 23 R. 4W

Well No. 1 - Fairfield

Olsen & Shell Company

Contractor

SW SE

SECTION PLAT

		0	

..... Ft. from N. Line

660 Ft. from S. Line

..... Ft. from E. Line

660 Ft. from W. Line

FIRST REPORTS

Location

Rig up.....

Drilling and Remarks:

RECORD

Cased.....in.,ft.

Sand.....

Gas.....

Oil.....

Total Depth.....

PRODUCTION

1st 24 hrs. Nat.....

1st 24 hrs. after shot.....

Gas.....Cu. Ft.

Dry Hole.....

Abandoned.....

Date

6/21/33 192 Orval Mann Scout

✓

Map No. 40 Sec. 27 Twp. 23 R. 4W

Well No. 1 - Guersfield

Olsen + Shell Company

Contractor

SECTION PLAT

Ft. from N. Line

660 Ft. from S. Line

Ft. from E. Line

660 Ft. from W. Line

ABANDONED

		0	

Location

Rig up

Drilling and Remarks:

W + H

RECORD

Cased in, ft.

Sand Hutton 3675

Gas

Oil

Total Depth 3695

PRODUCTION

1st 24 hrs. Nat.

1st 24 hrs. after shot

Gas Cu. Ft.

Dry Hole

Abandoned

Date

9/6/33 O. Mannebeck

