


Section 27 Township 23 Range 4-W

Well No. 3 - Querfeld

Company Olson Drig.

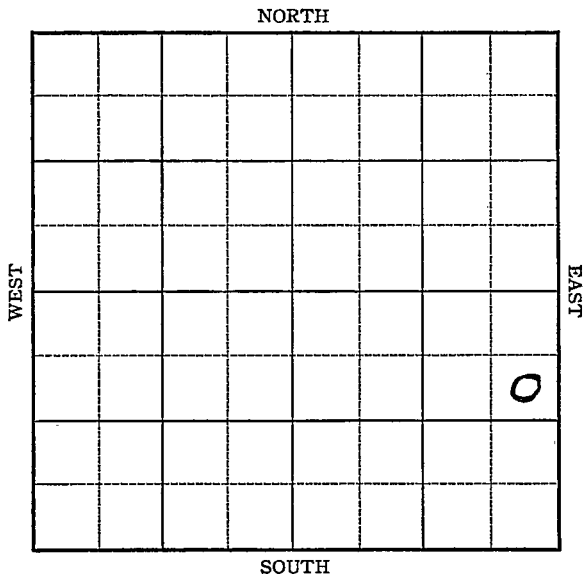



1937

11/12 P.B. 3400'.  
Perforated pipe 3313-3334'.  
1000 acid.

11/19 " "

11/23 5" @ 3604'.  
Hunton 3609'.  
T.D. 3618'.  
P.B. 3400'.  
60 shots ~~33~~14-34'.  
1000 acid.  
Potential 222 bbls. S.W.

COMPLETED

Peno KANSAS

Map No. \_\_\_\_\_ Sec. 27 Twp. 23 R. 4WWell No. 3-QuarfieldOlson Drilling Company

Contractor

## FIRST REPORT

## SECTION PLAT


990 Ft. from N. Line

\_\_\_\_\_ Ft. from S. Line

330 Ft. from E. Line

\_\_\_\_\_ Ft. from W. Line

Location \_\_\_\_\_

Rig up \_\_\_\_\_

Drilling and Remarks:

Cellar

## RECORD

Cased \_\_\_\_\_ in., \_\_\_\_\_ ft.

Sand \_\_\_\_\_

Gas \_\_\_\_\_

Oil \_\_\_\_\_

Total Depth \_\_\_\_\_

## PRODUCTION

1st 24 hrs. Nat. \_\_\_\_\_

1st 24 hrs. after shot \_\_\_\_\_

Gas \_\_\_\_\_ Cu. Ft.

Dry Hole \_\_\_\_\_

Abandoned \_\_\_\_\_

Date

SEP 1 1937 19

H. D. Hatfield Scout

Map No. 40 Sec. 27 Twp. 23 R. 4WWell No. 3 QuerfeldOlson Drlg. Company

Contractor

**COMPLETED**

SE NE SE

990 Ft. from N. Line       Ft. from S. Line330 Ft. from E. Line       Ft. from W. Line**SECTION PLAT**

			0

Location \_\_\_\_\_

Rig up \_\_\_\_\_

Drilling and Remarks:

*P.B. 3400**60 shots 3314-34**1000 acid**POT-222  
S.W.***RECORD**Cased 5 in., 3604 ft.~~Sand~~ Hutton 3609

Gas \_\_\_\_\_

Oil \_\_\_\_\_

Total Depth 3618**PRODUCTION**

1st 24 hrs. Nat. \_\_\_\_\_

1st 24 hrs. after shot \_\_\_\_\_

Gas \_\_\_\_\_ Cu. Ft.

Dry Hole \_\_\_\_\_

Abandoned \_\_\_\_\_

Date

NOV 23 1927 19 H. D. Hatfield Scout