

KANSAS

FORM 51 5M 10-41 PETROL

Stafford


Section 27 Township 23 Range 12-W

Well No. #1 Allen "B"

Company Stanolind

Bedford Pool

NORTH

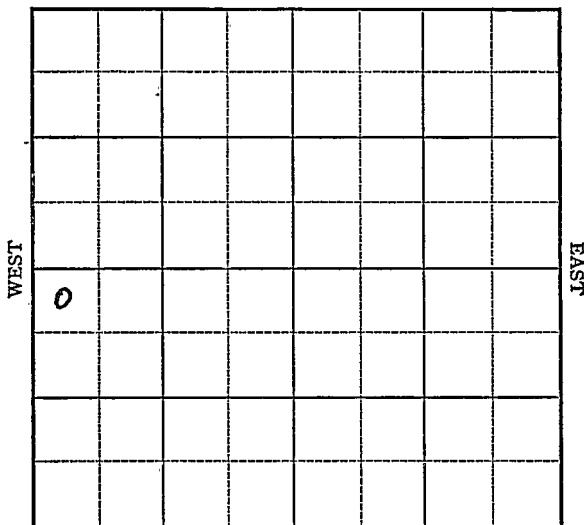

SOUTH

KANSAS

Stafford

Sec. 27 Twp. 23 R. 12-W

Well No. #1 Allen "B" Farm

Stanolind Company

(Bedford)


330 Ft. from N. Line

_____ Ft. from S. Line

_____ Ft. from E. Line

330 Ft. from W. Line

Elev. 1859

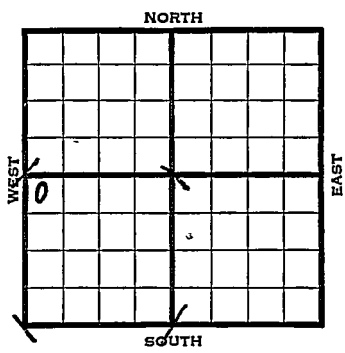

| 1942 | REPORT |
|------|-----------------------------------|
| 1/7 | Location |
| 1/15 | Derrick. |
| 1/22 | 8" - 338' WOC. |
| 1/29 | Drlg. 2917' |
| 2/5 | 3606' drill pipe stuck. |
| 2/12 | Lans. 3400' Cong. 3694' |
| | Simp. 3763' Arb. 3829-39' T.D. |
| | 5" - 3830' RUST. S.O. |
| 2/19 | 1000 acid. Swab 22 oil per hour 3 |
| | hours. 2800' off bottom. |
| | |
| | |
| | |
| | |
| | OVER |
| | |
| | |
| | |
| | |
| | |

1942
2/25

Arb. 3829'

5" - 3830'

T.D. 3839'

1000 acid.

Depthograph potential 4794 bbls.

Maximum 3000 bbls.

36. Gravity

COMPLETED

Stafford

KANSASMap No. 47 Sec. 27 Twp. 23 R. 12WWell No. 1 Allen "B"Stanolind

Company

FIRST REPORTS

Contractor

NW SW


330 Ft. from N. Line

Ft. from S. Line

Ft. from E. Line

330 Ft. from W. Line

SECTION PLAT

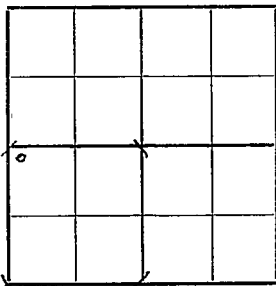

BEDFORD POOL

Location XX

Rig up _____

Drilling and Remarks:

RECORD

Cased _____ in., _____ ft.

Sand _____

Gas _____

Oil _____

Total Depth _____

PRODUCTION

1st 24 hrs. Nat. _____

1st 24 hrs. after shot _____

Gas _____ Cu. Ft.

Dry Hole _____

Abandoned _____

Date

JAN 7 1942

19

S. J. LEWIS Scout

Stafford

KANSAS

Map No. 47 Sec. 27 Twp. 23 R. 12W

Well No. 1 Allen "B"

Stanolind Company

COMPLETED Contractor

NW SW

SECTION PLAT

330 Ft. from N. Line

_____ Ft. from S. Line

_____ Ft. from E. Line

330 Ft. from W. Line

| | | | |
|---|--|--|--|
| | | | |
| | | | |
| 0 | | | |
| | | | |

BEDFORD POOL

Location _____

Rig up _____

Drilling and Remarks:

*Per 3529
5" @ 3880.
1000 acid
Depth Per 4794
Max 3000
36° SW*

RECORD

Cased _____ in., _____ ft.

Sand _____

Gas _____

Oil _____

Total Depth 3889

PRODUCTION

1st 24 hrs. Nat. _____

1st 24 hrs. after shot _____

Gas _____ Cu. Ft.

Dry Hole _____

Abandoned _____

Date

FEB 25 1942 19

S. J. LEWIS Scout